

UNITED STATES
DEPARTMENT OF THE INTERIOR
BUREAU OF LAND MANAGEMENT

SECTION


2

NE $\frac{1}{4}$ SE $\frac{1}{4}$

Oregon State Water Filings

TOWNSHIP 31S, RANGE 28E, W. M.

North

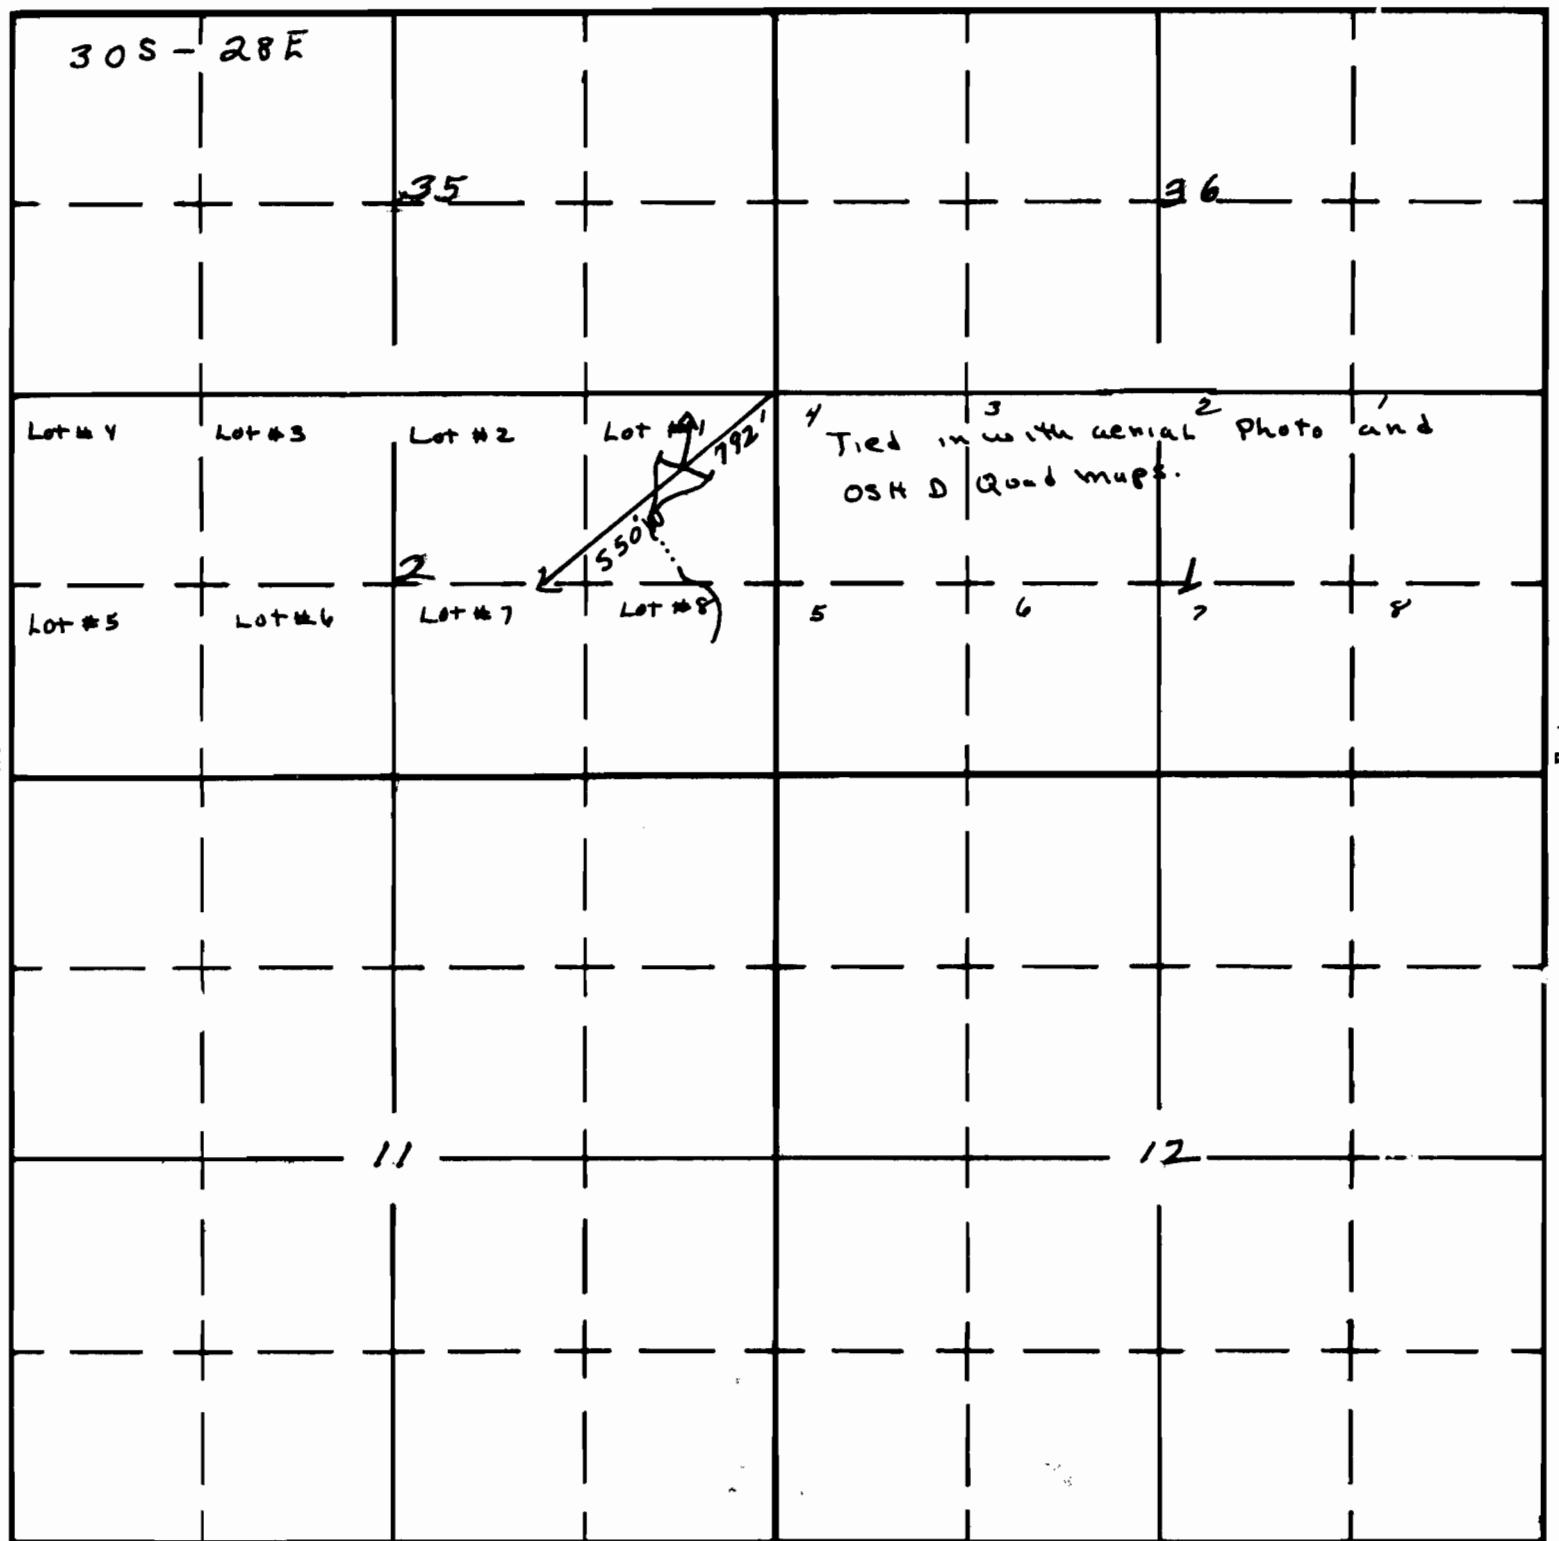

South

APPLICATION No. R-35742
PERMIT No. R-4067