

UNITED STATES
DEPARTMENT OF THE INTERIOR
BUREAU OF LAND MANAGEMENT

SECTION


12

SW $\frac{1}{4}$ NW $\frac{1}{4}$

Oregon State Water Filings

TOWNSHIP 38S, RANGE 27E, W. M.

North

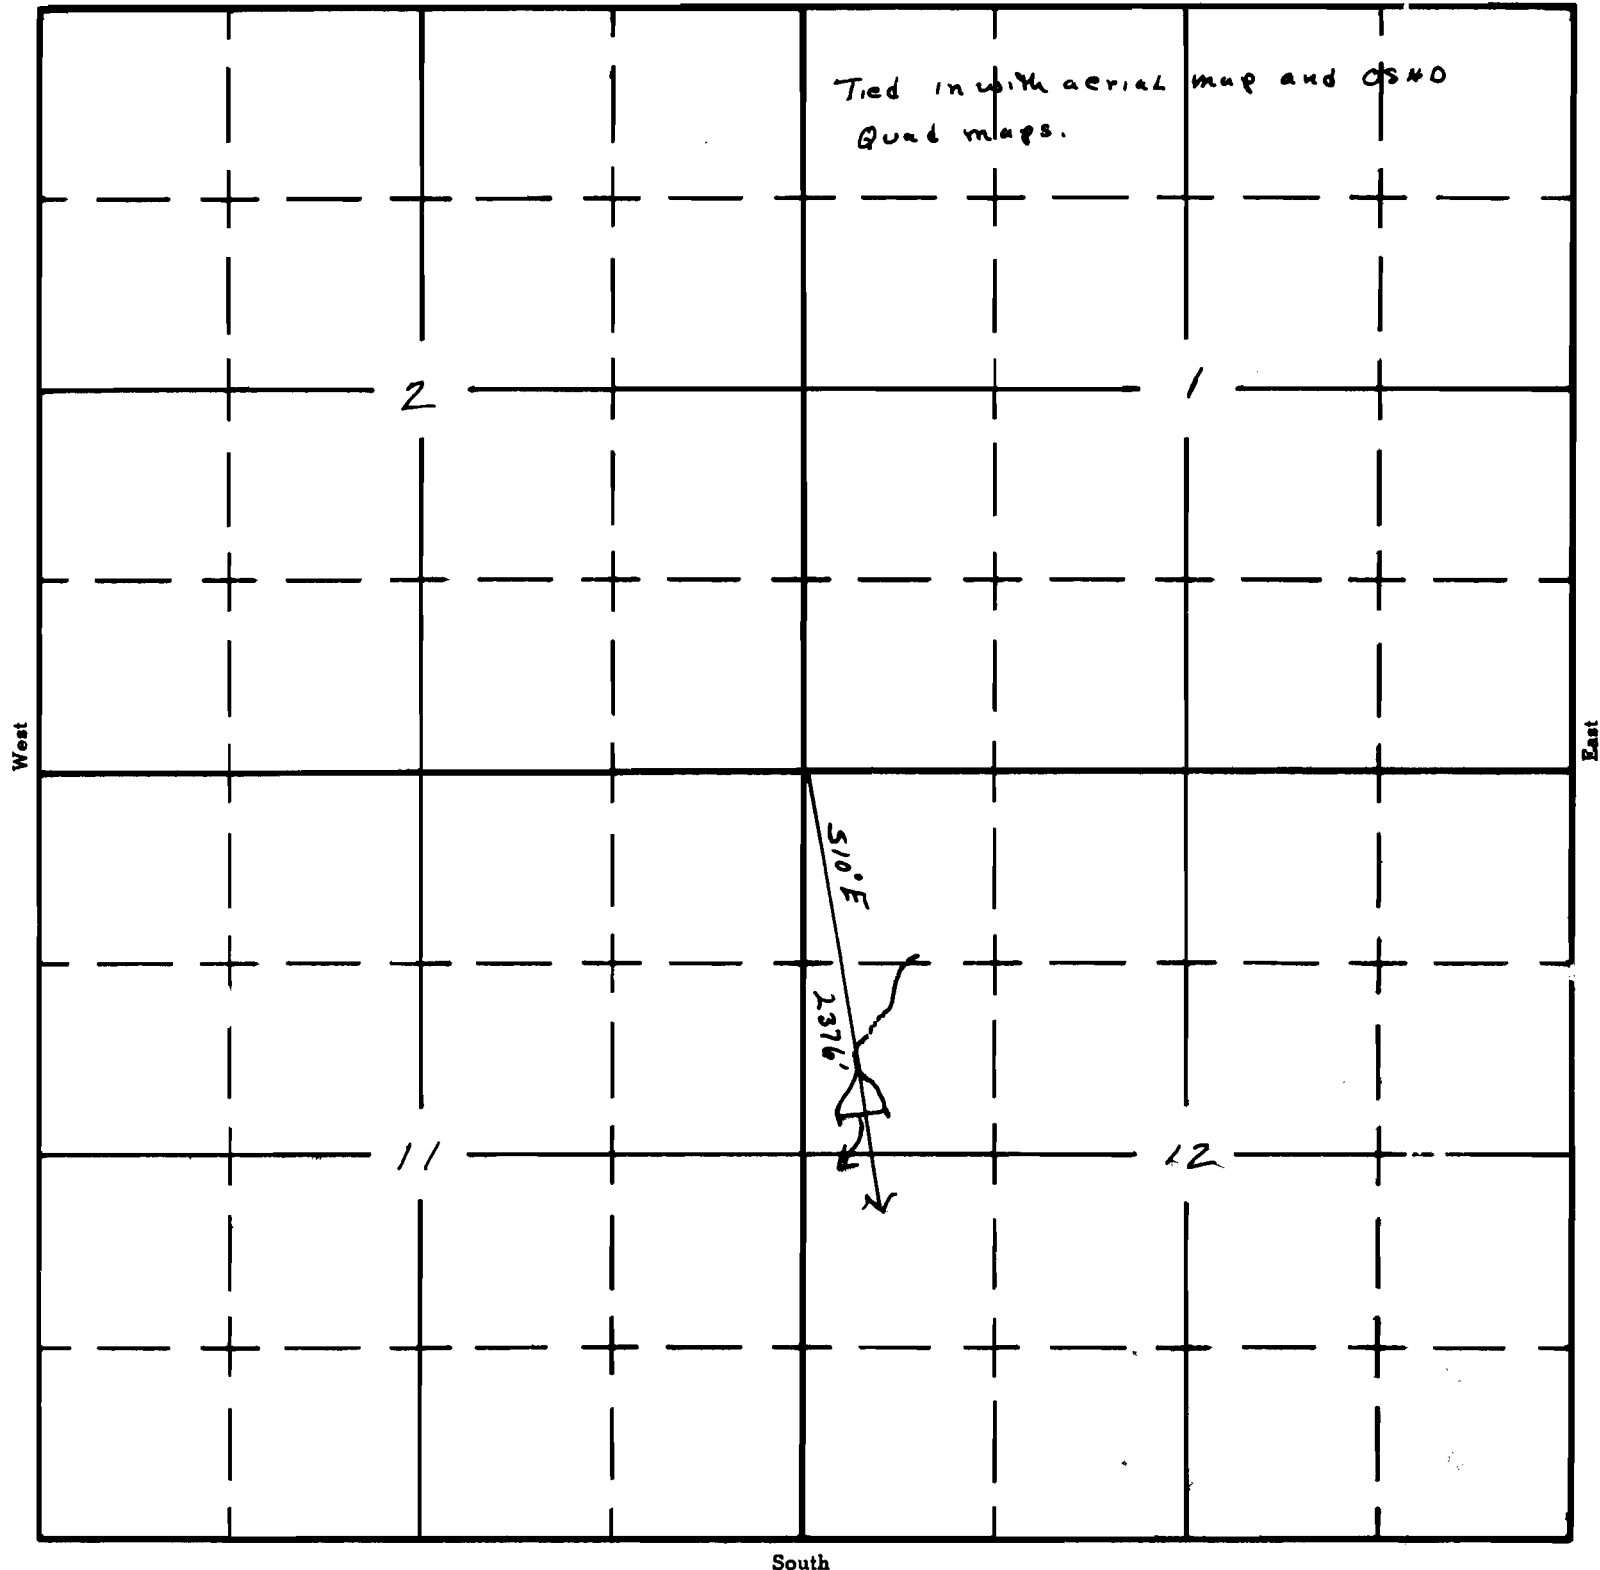

South

APPLICATION No. R-35749
PERMIT No. R-4070