

UNITED STATES
DEPARTMENT OF THE INTERIOR
BUREAU OF LAND MANAGEMENT


SECTION

Oregon State Water Filings

NW 1/4 SW 1/4

TOWNSHIP 32 S, RANGE 28 E, W. M.

Tied in with aerial photos & O.S.H.D. Quad maps.

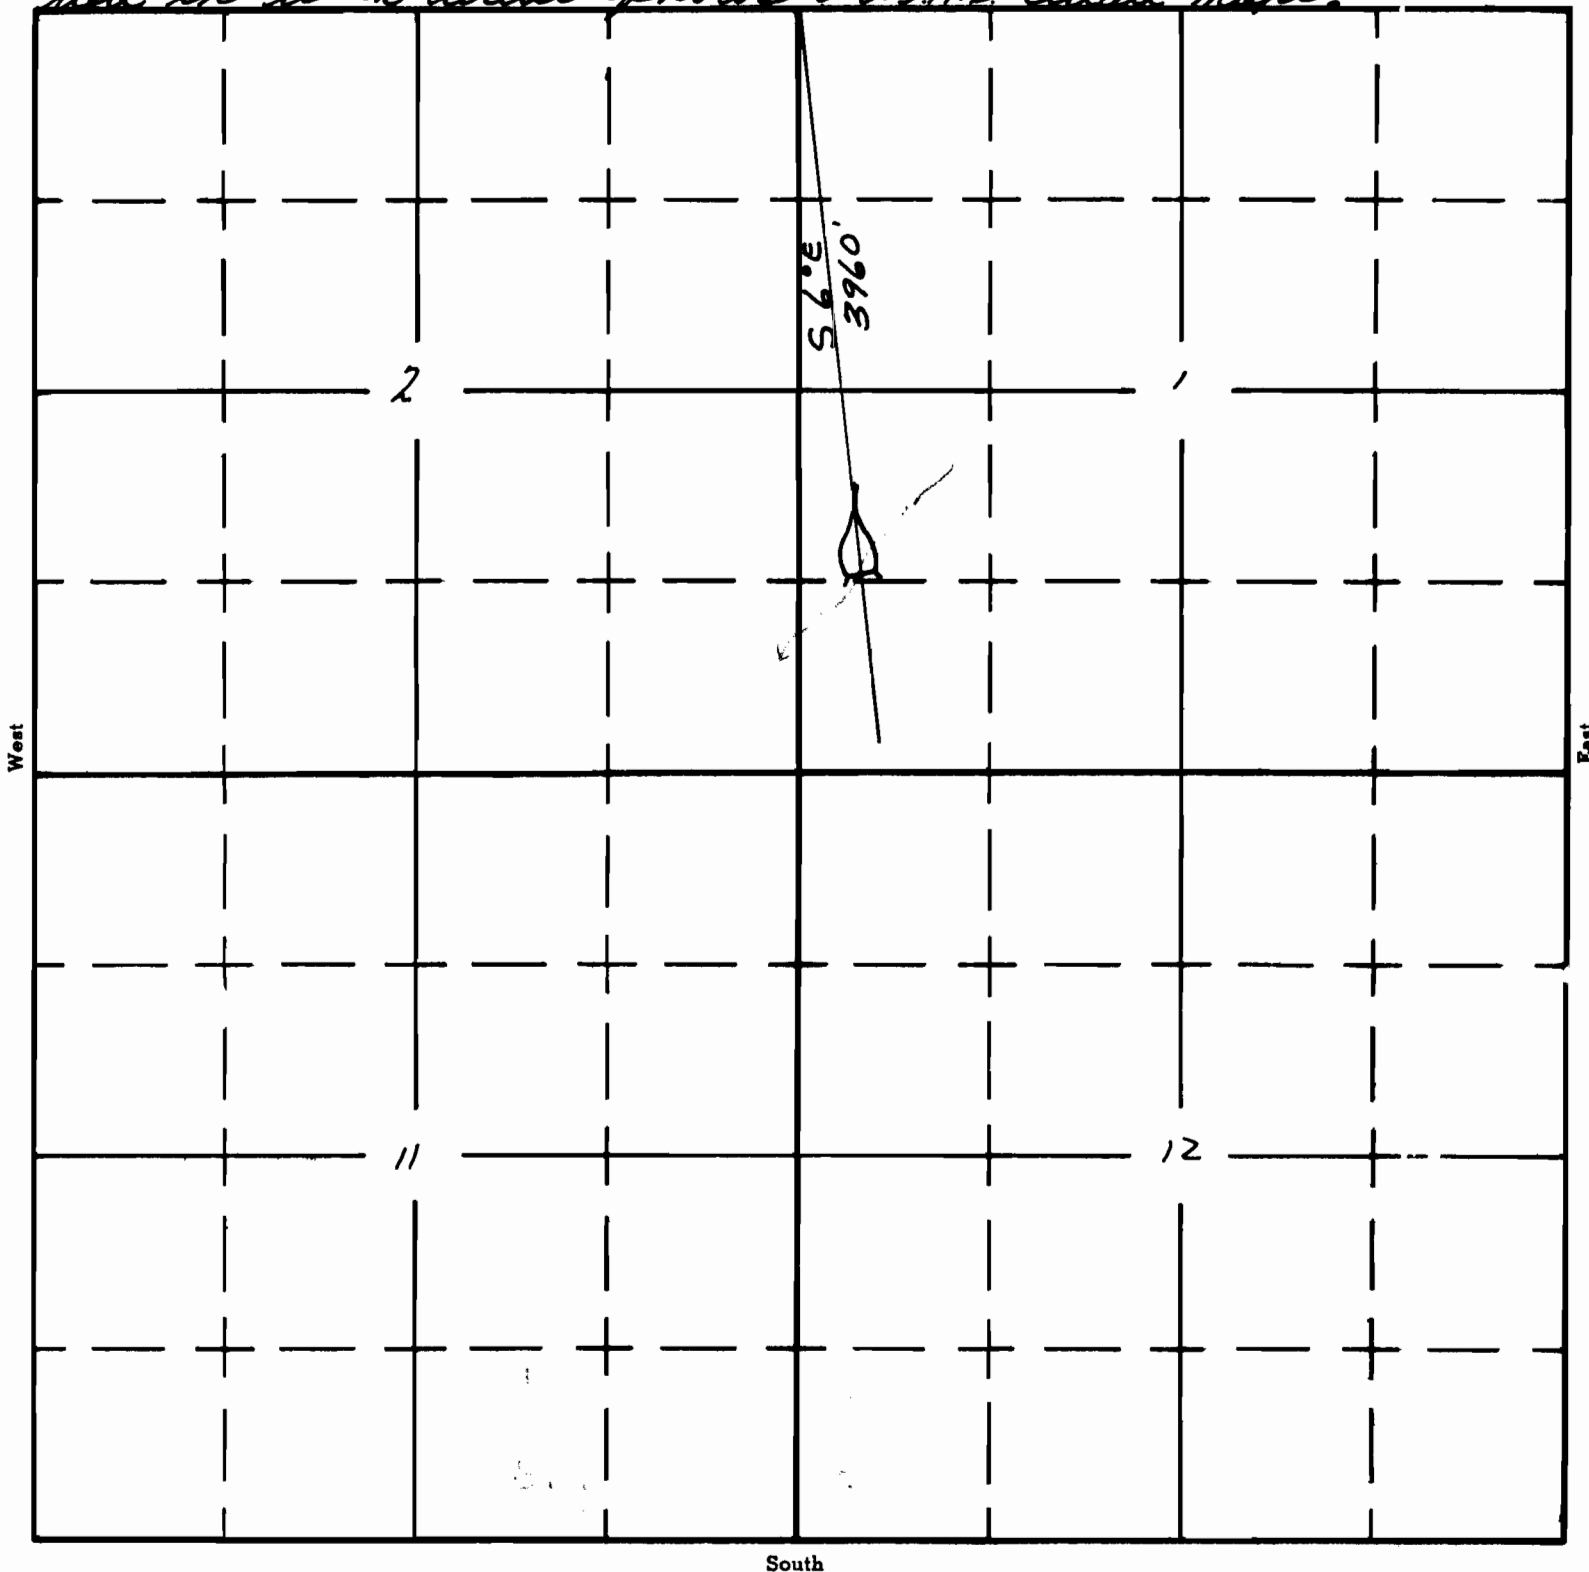

South

APPLICATION No. **R-35755**

PERMIT No. **R-4073**