

UNITED STATES
DEPARTMENT OF THE INTERIOR
BUREAU OF LAND MANAGEMENT


SECTION

Oregon State Water Filings

NW 1/4 SE 1/4

TOWNSHIP 32 S, RANGE 28 E, W. M.

Tied in with aerial photos and O.S.H.D. Quad Maps.

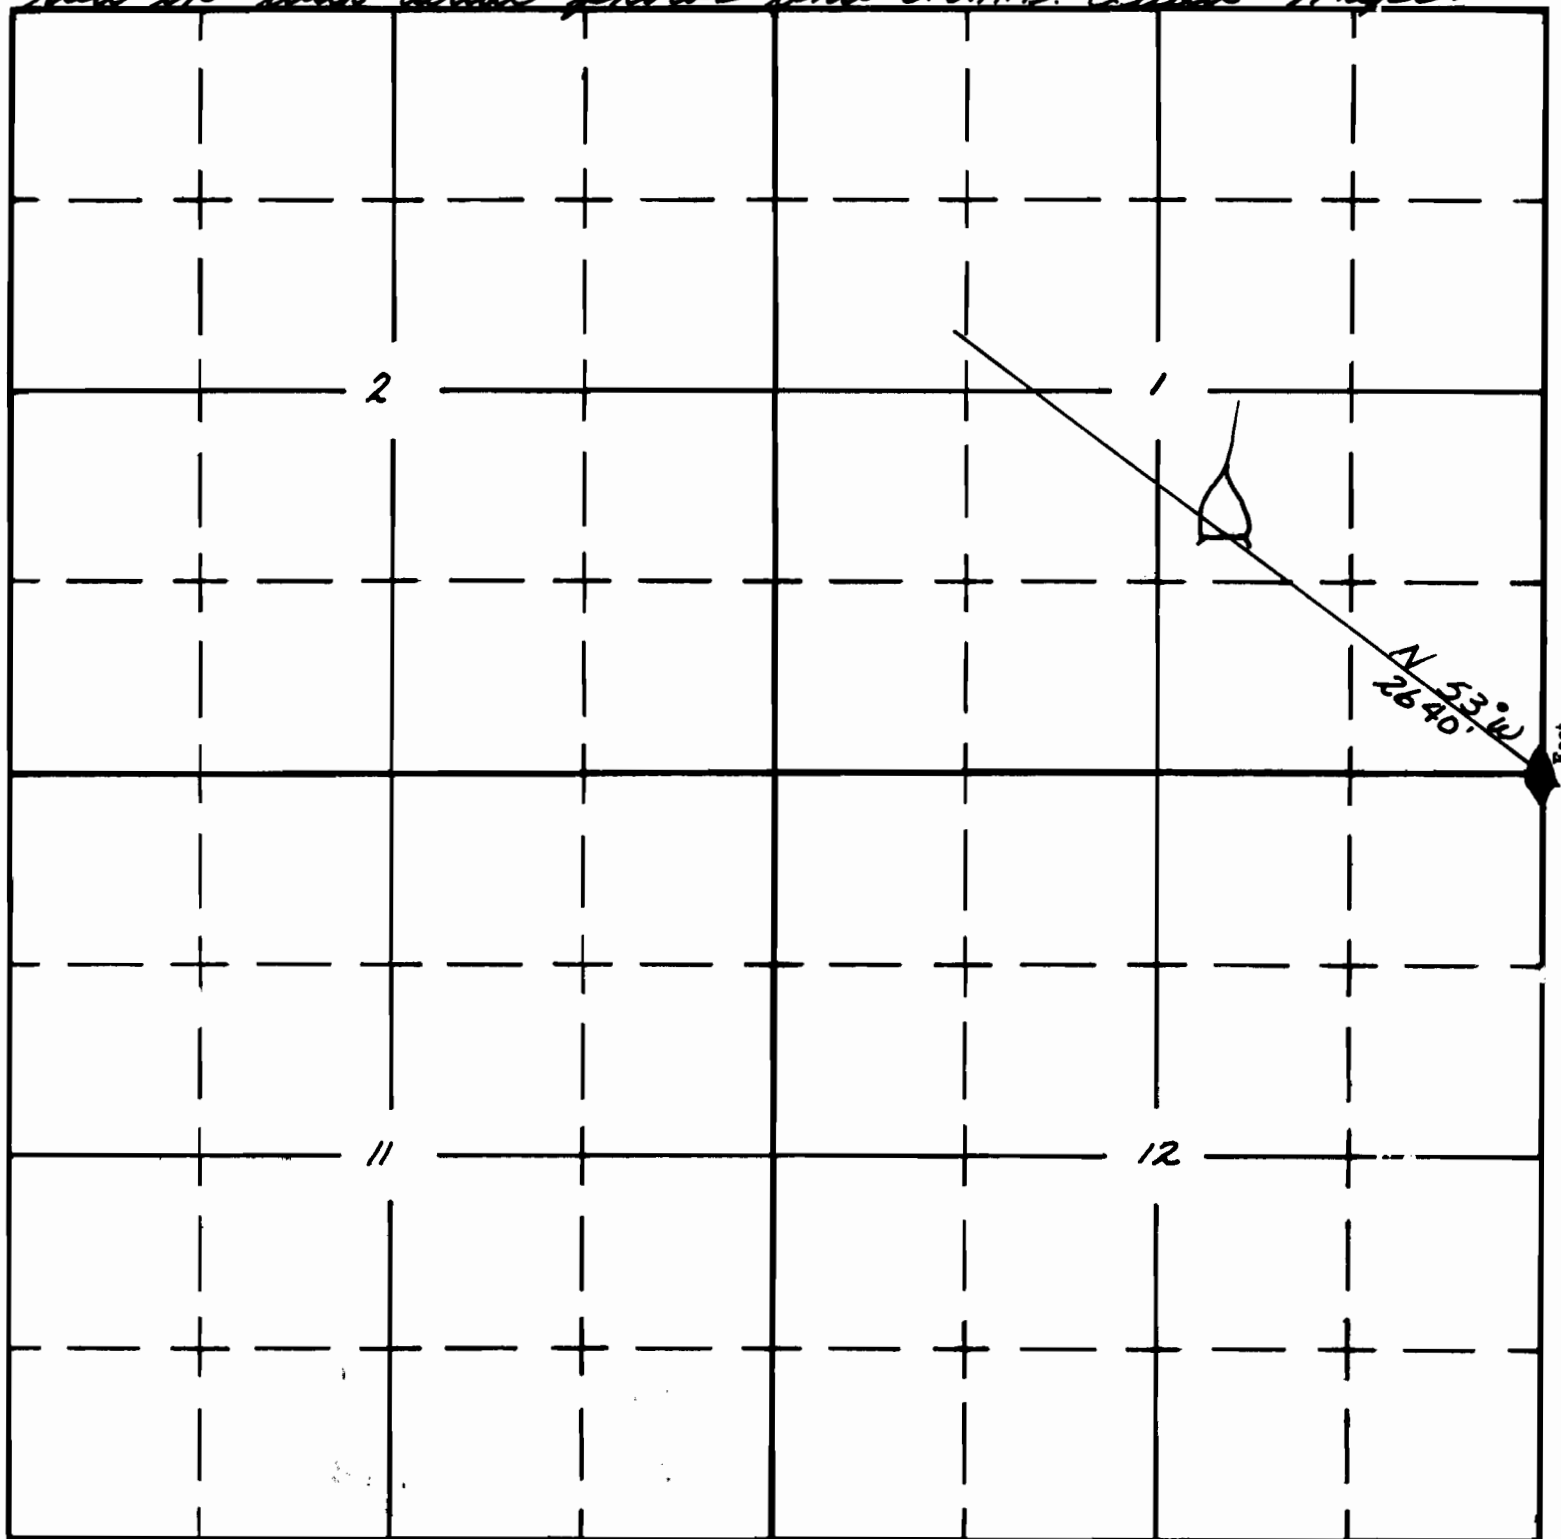

South

APPLICATION No. R-35756

PERMIT No. R-4074