

Form A1-187
March 1961

UNITED STATES
DEPARTMENT OF THE INTERIOR
BUREAU OF LAND MANAGEMENT


SECTION 17

Oregon State Water Filings

SW¹/₄ SE¹/₄

TOWNSHIP 38 S, RANGE 26 E, W. M.

Tied-in with aerial photos and O.S.H.D. Quad Maps.

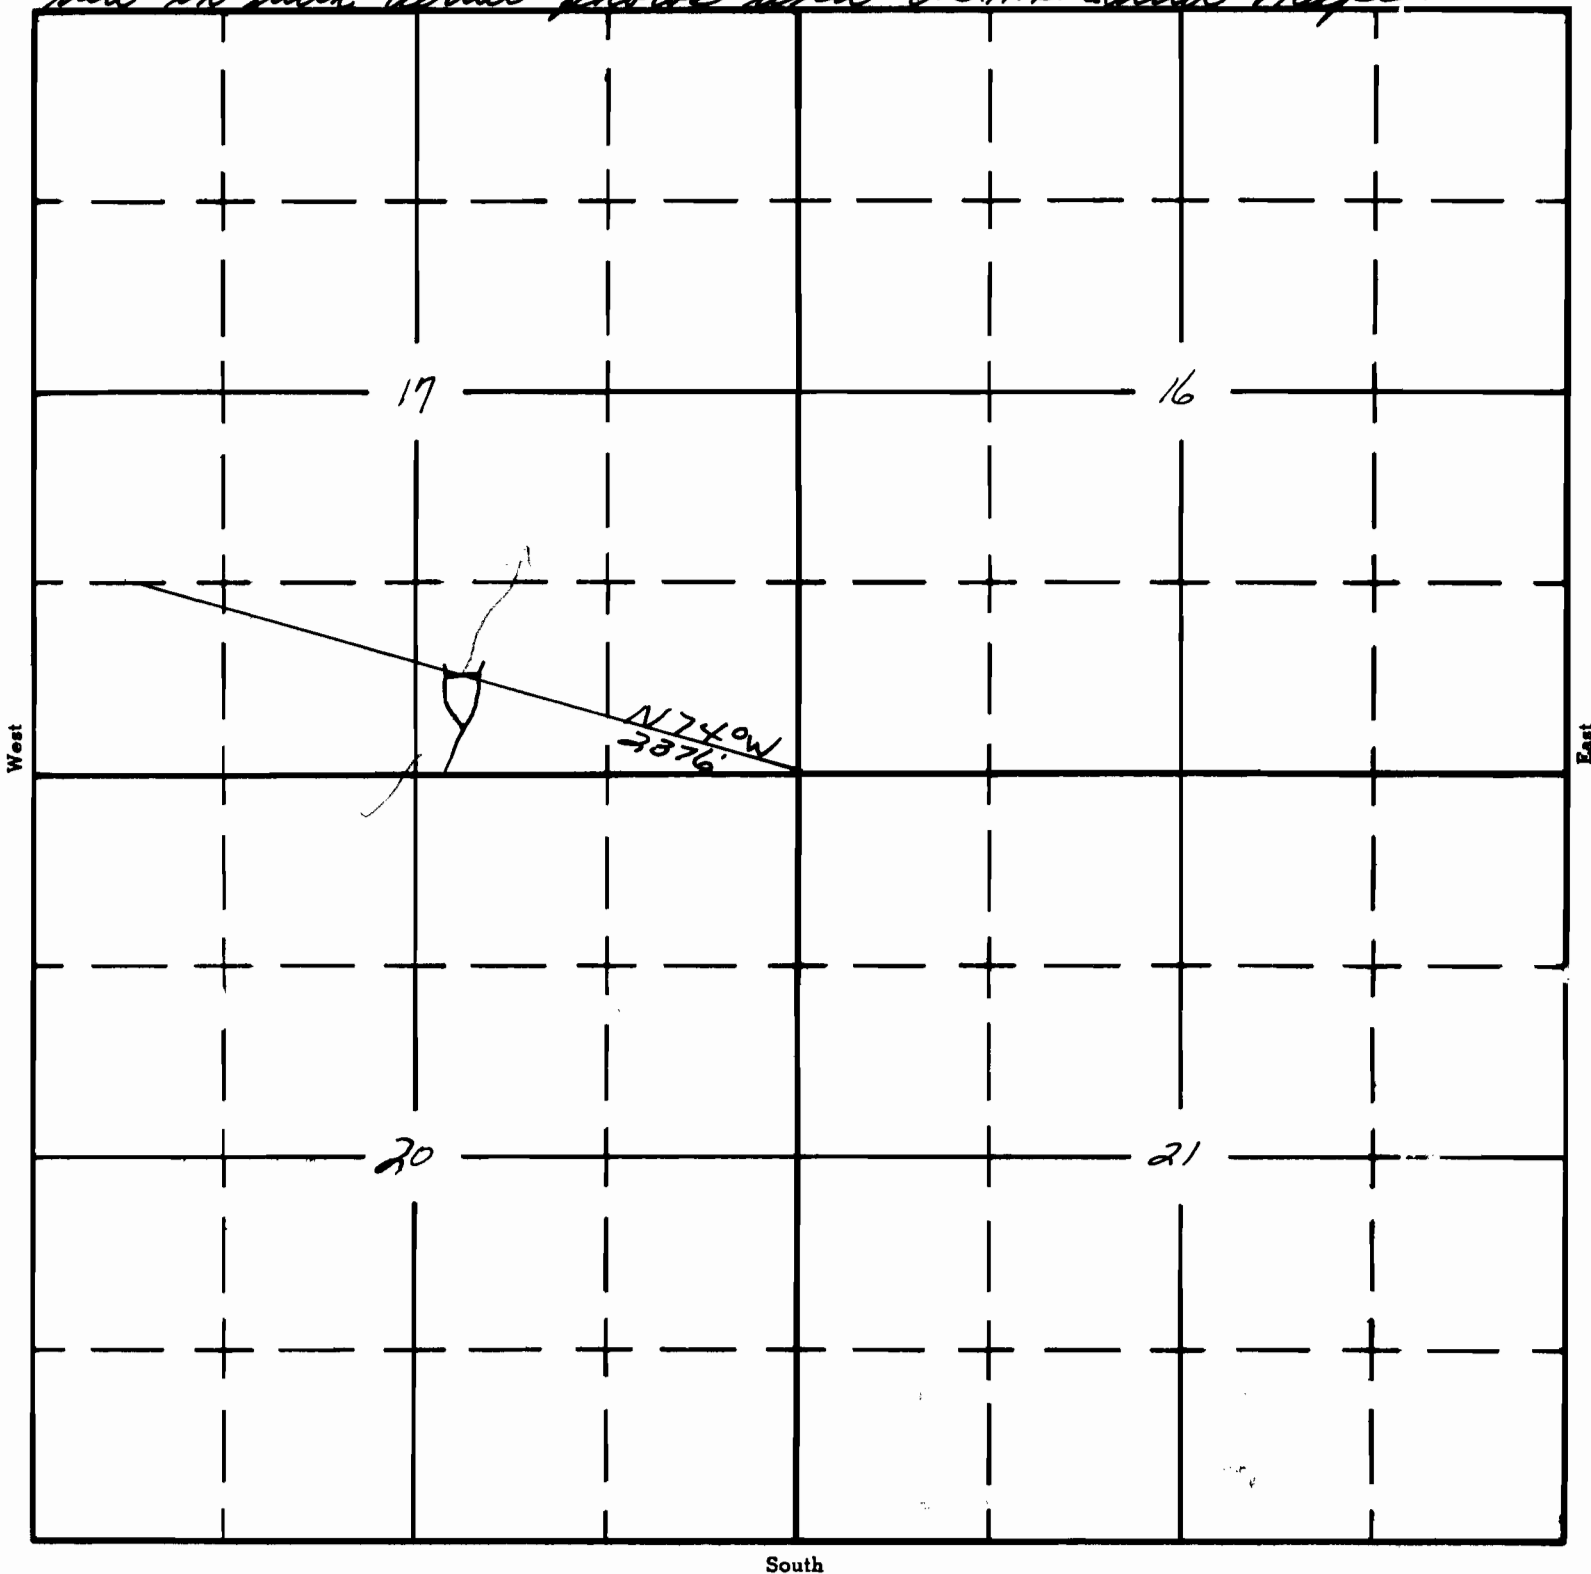

APPLICATION No. R-35787
PERMIT No. R-4075