

Form AI-187
March 1961

UNITED STATES
DEPARTMENT OF THE INTERIOR
BUREAU OF LAND MANAGEMENT

SECTION


21

Oregon State Water Filings

SE 1/4 SE 1/4

TOWNSHIP 38 S, RANGE 26 E, W. M.

Tied-in with aerial photos and O.S. H.D. Quad Maps.

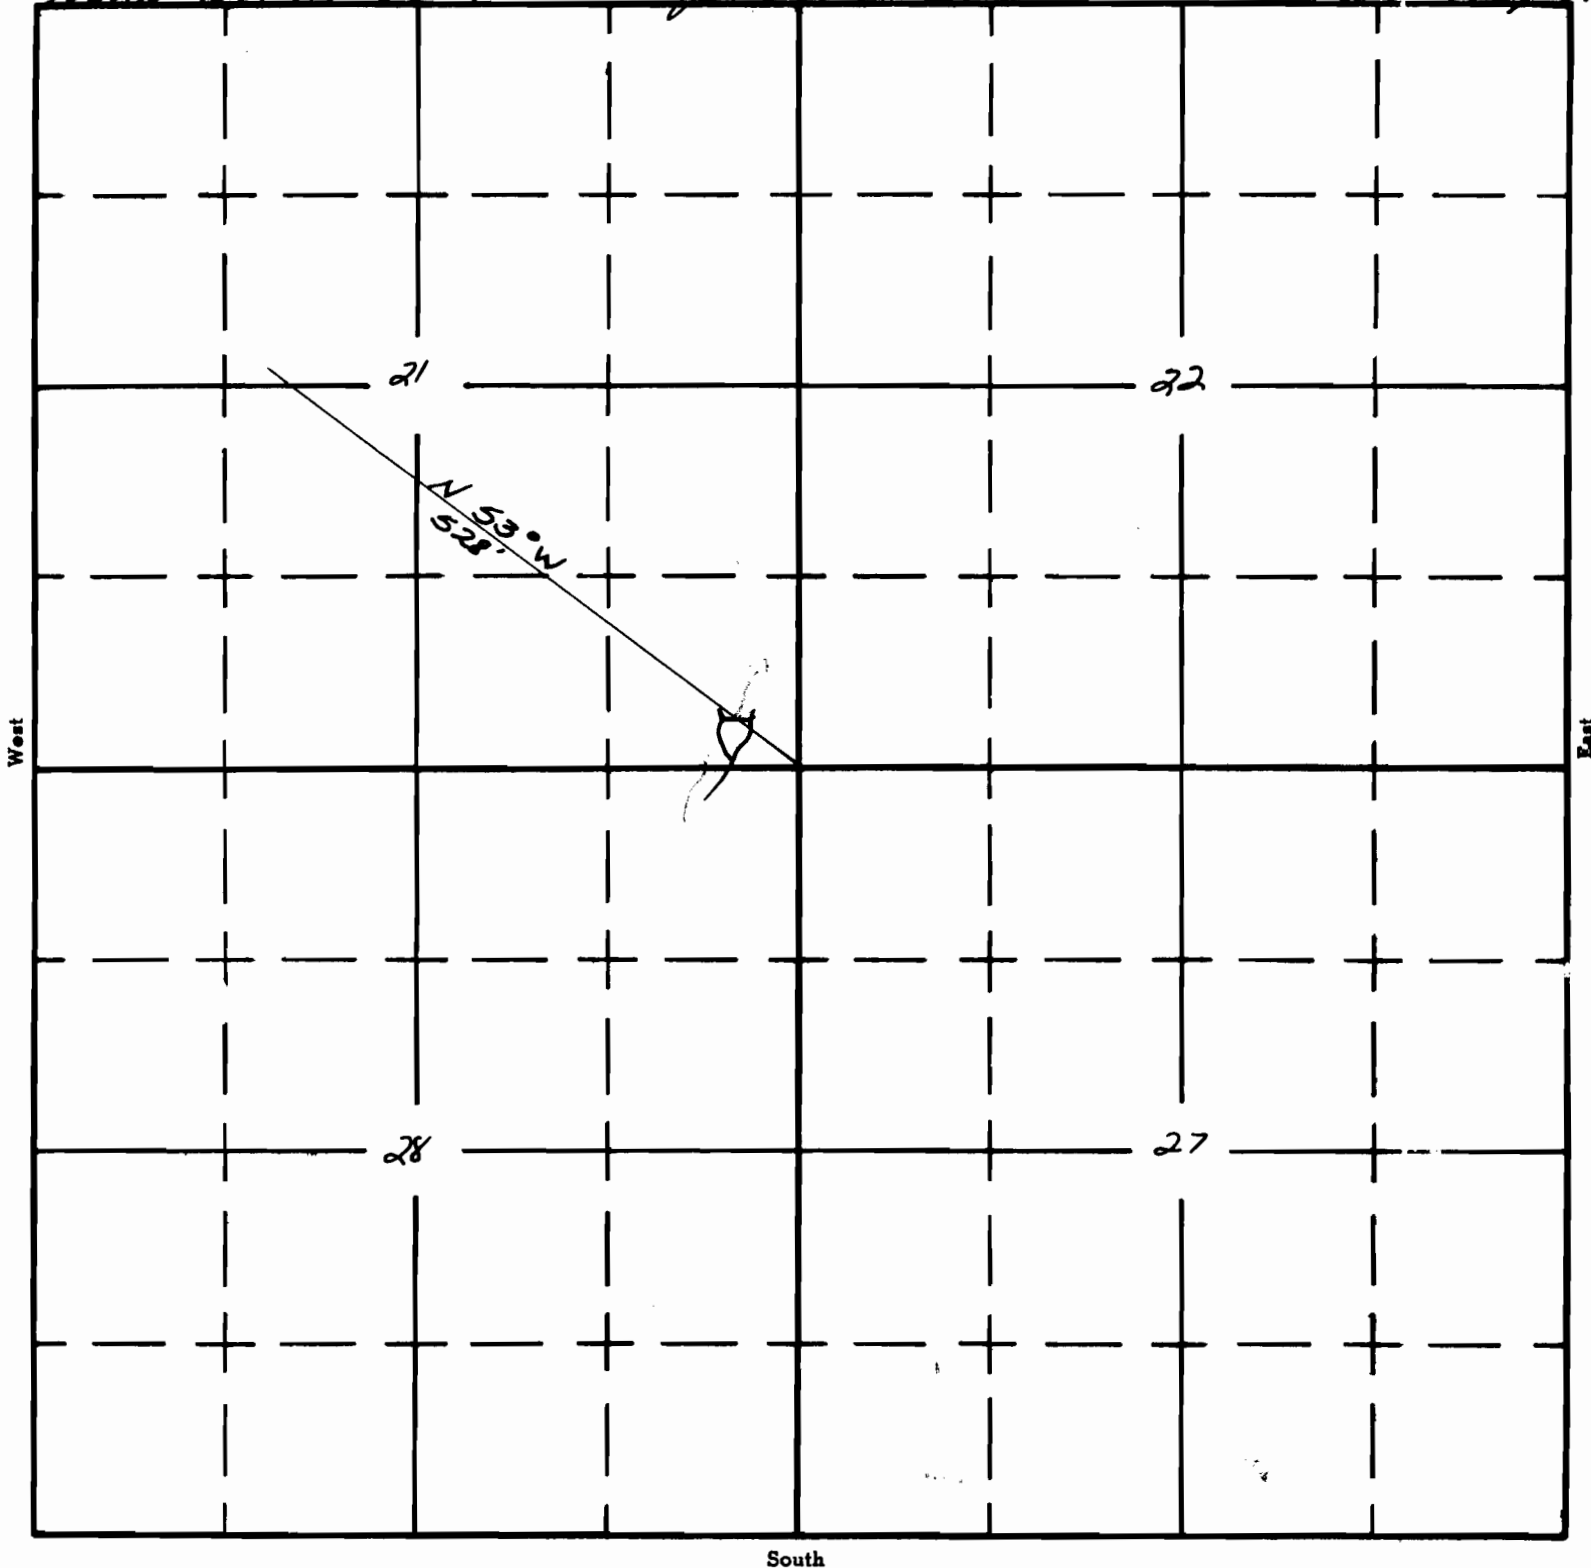

APPLICATION No. R-35793

PERMIT No. R-4079