


G8196

52631  
T8020  
77738

# T.27S. R.17E. WM.

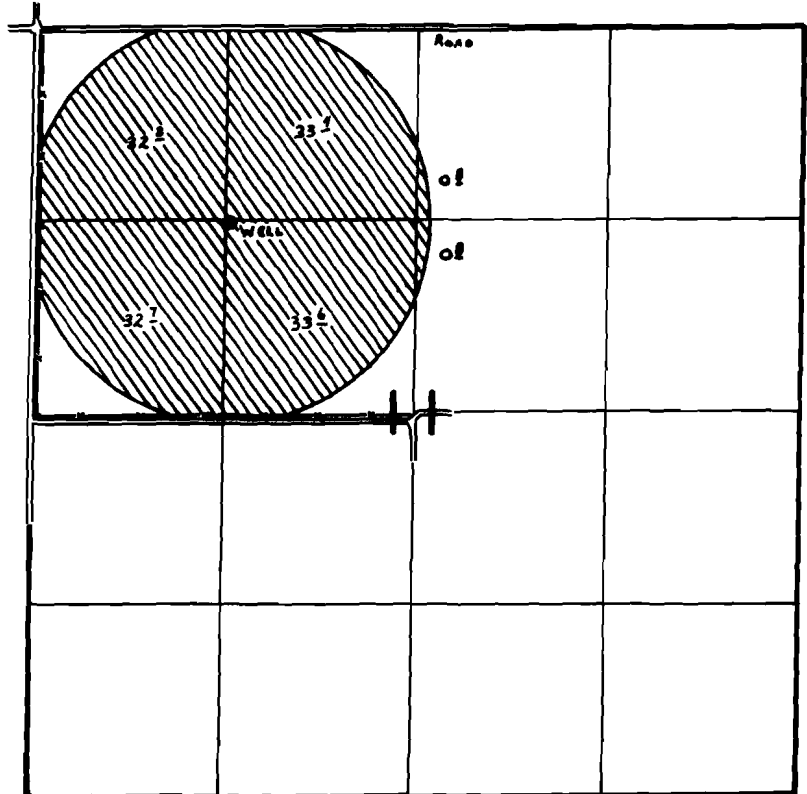

WELL LOC: 1340'S. & 1340'E. fr. N.W. Cor. SEC. 11.

## FINAL PROOF SURVEY UNDER

Application No. G-8748 Permit No. G-8196  
IN NAME OF

GOLDEN RULE FARMS, INC.

Surveyed Aug. 24, 1979, by C. L. HUGHES