


G-8330  
G-9203  
53347  
T8000  
77739

# T.27S. R.17E. W.M.

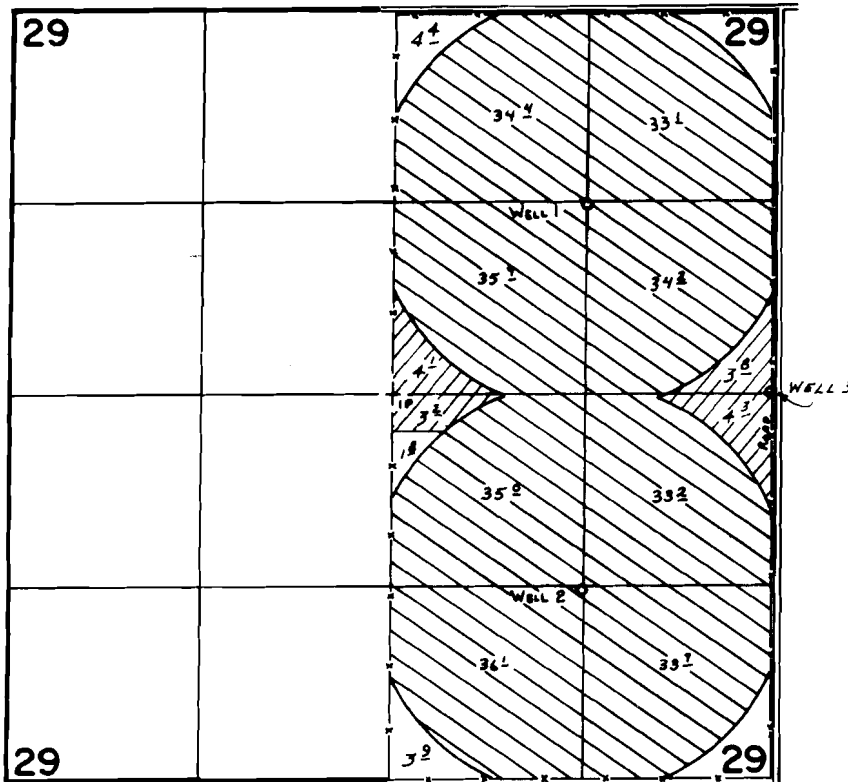

WELLS LOC:

- 1- 1300' N. & 1320' E.
  - 2- 1340' S. & 1310' E.
  - 3- 2400' E.
- ALL FROM C. 1/4 COR. SEC. 29.

## FINAL PROOF SURVEY UNDER

G-10132                      G-9203

Application No. ~~G-8924~~ Permit No. ~~G-8330~~

IN NAME OF

...WILLIAM L. & JANELLE I. BUERMANN...

Surveyed Aug. 24, 1979, by ...C. L. HUGHES...  
NOV. 1 1984                      B. W. BISHOP