


G-9065
55098
T8020
77741

T. 26S., R. 18E., W.M.

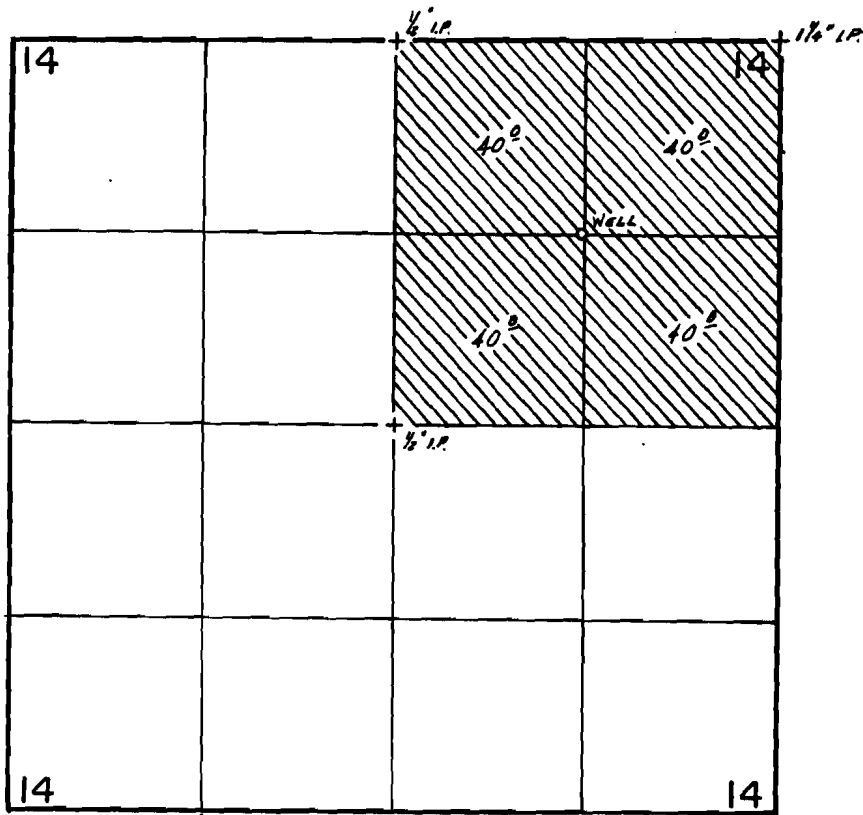

WELL LOC.: 1320 S. & 1340 W. FROM NE COR. SEC. 14.

SCALE: 1" = 1320'

FINAL PROOF SURVEY UNDER

Application No. G-9820 Permit No. G-9065....
IN NAME OF

.....GOLDEN RULE FARMS, INC.....

Surveyed Sept. 17, 1985, by B.W. BISHOP.....