


G 8888  
 T 8020  
 51770  
 77742  
 T 8020  
 T 9814

T.27S.,R.17E.,W.M.

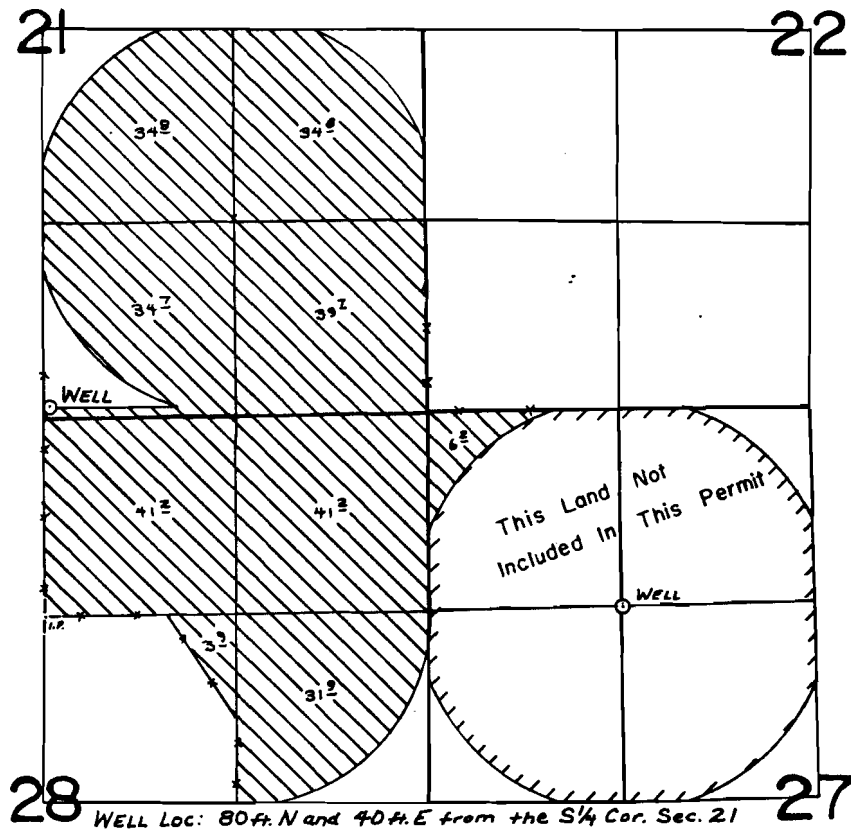

**FINAL PROOF SURVEY**  
 UNDER

Application No. G-9831. Permit No. G-8888.....  
 IN NAME OF

.....**MARVIN G. NAGELY**.....

Surveyed OCT. 29. 1981., by L. TOLL.....