


T. 38 S., R. 11 E., W. W.


Buck Cr. i Yuma Valley Weeds

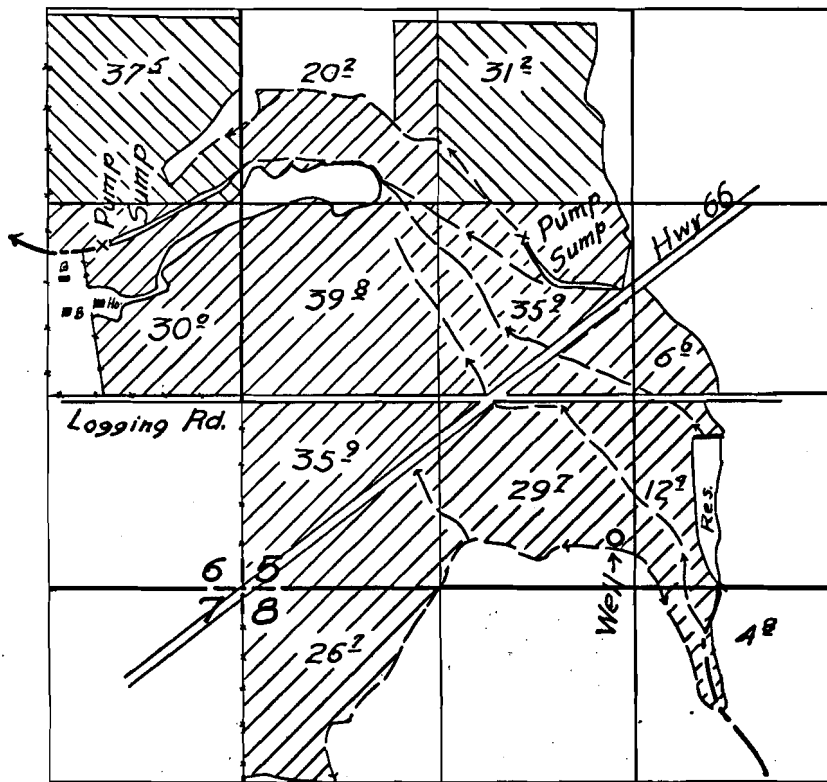


FINAL PROOF SURVEY

UNDER

U-269

U-238 

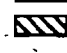Application No. U-402... Permit No. U-377... 

IN NAME OF

.....LEONARD G. RITTER.....

Surveyed 14 May... 1955., by H.L. Coffman..