


U-238  
22844  
6867

# T. 38S, R. 11E, W. 11N

Buck Creek: Yonna Valley wells

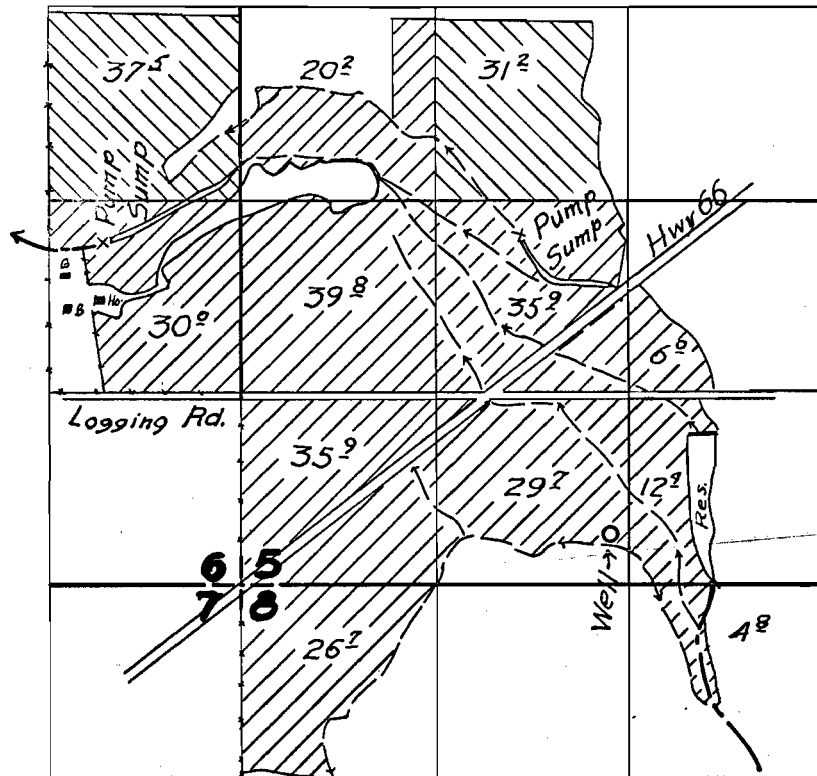

## FINAL PROOF SURVEY

UNDER

U-269

U-238



Application No. U-402

Permit No. U-372



IN NAME OF

LEONARD G. RITTER

Surveyed 14 May, 1955, by H.L. Coffman.