


T.22 S. R.7W.W.M.

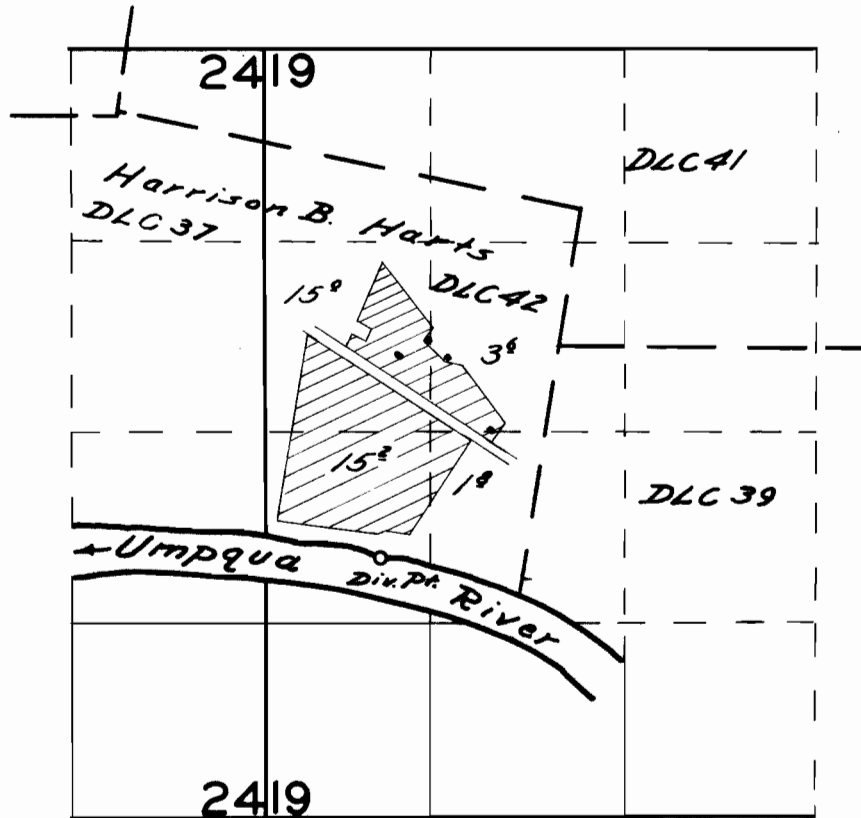

**FINAL PROOF SURVEY**

UNDER

Application No. *25921* Permit No. *20332*

IN NAME OF

*Oliver Haines*

Surveyed *July 11, 1956*, by *C.O. Bartels*