
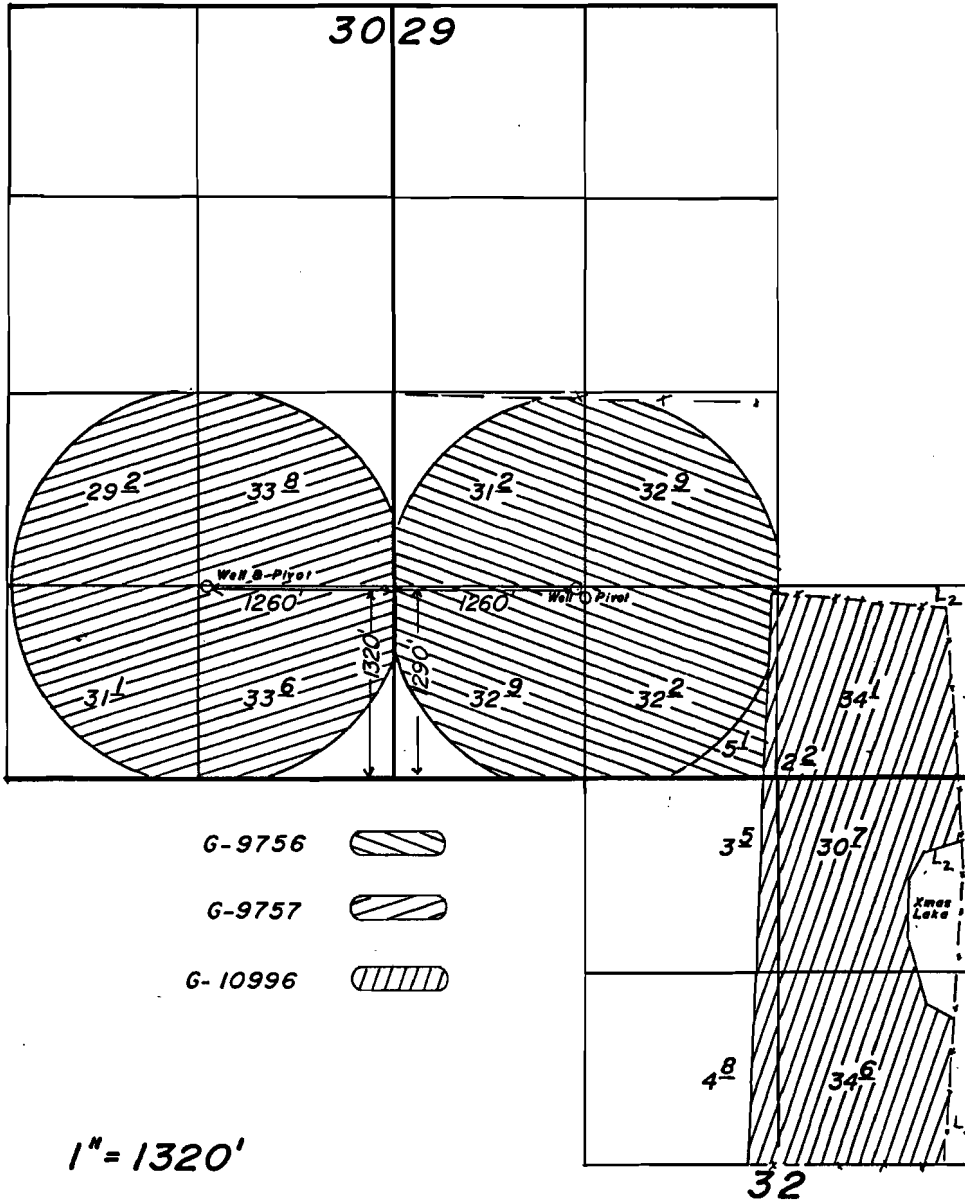


T. 26 S., R. 18 E., W.M.

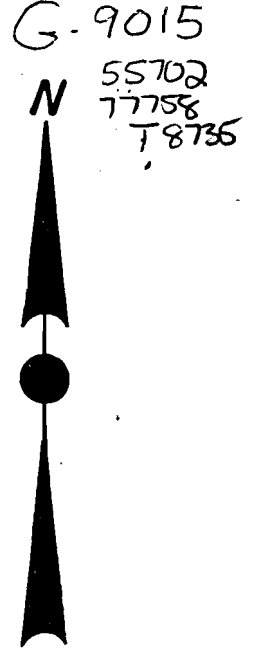

- G-9756
- G-9757
- G-10996

1" = 1320'

FINAL PROOF SURVEY

UNDER

G-9756 ✓ G-9015 ✓
G-9757 ✓ G-9016 ✓

Application No. ~~G-10996~~ Permit No. ~~G-10172~~....

IN NAME OF

LARRY GRASSMAN

Surveyed Oct. 25, 1984, by Leslie Olson.....

PTS-11-1984-D

T.M.W.