


T. 26 S., R. 18 E., W. M.

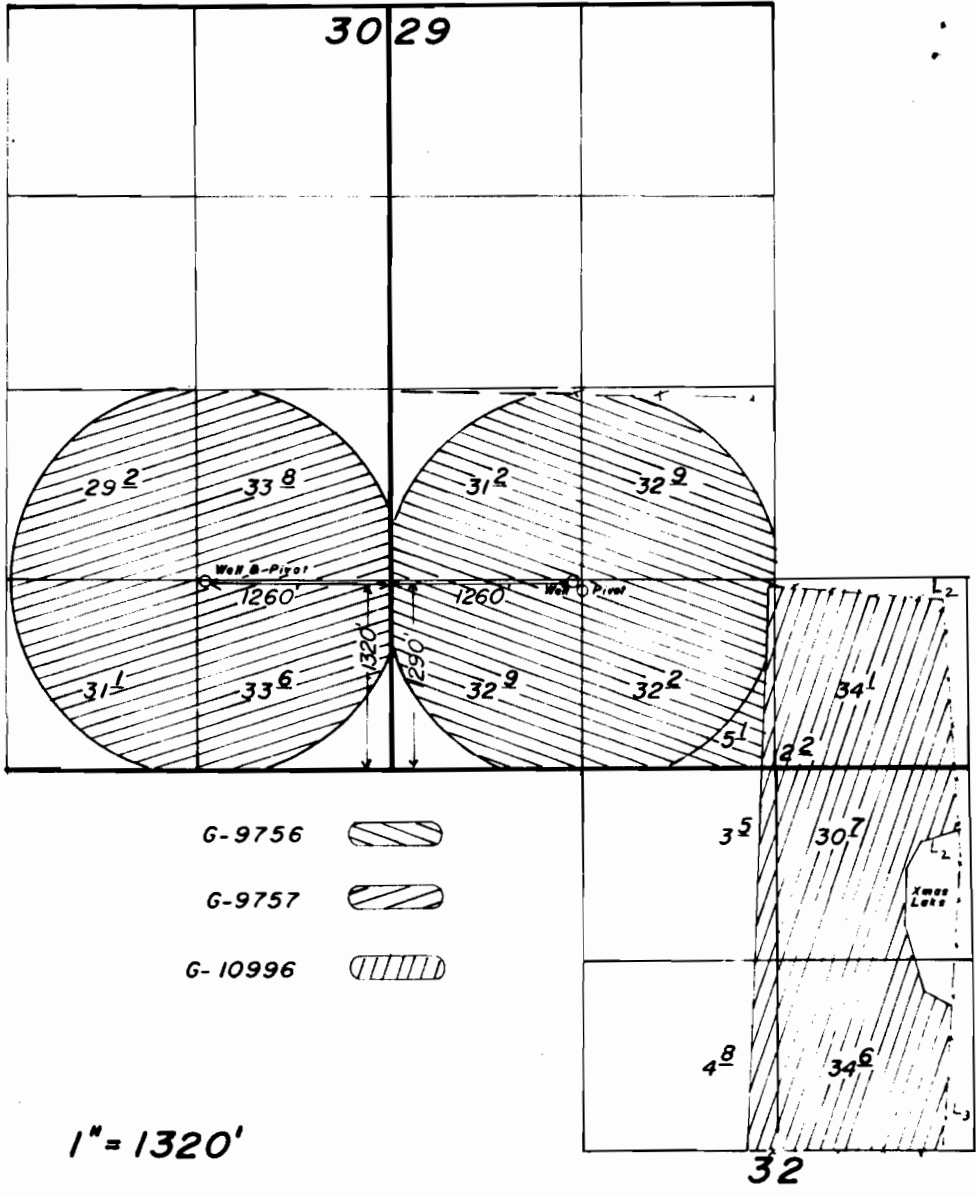

- G-9756
- G-9757
- G-10996

1" = 1320'

FINAL PROOF SURVEY

UNDER

G-9756 G-9015
 G-9757 G-9016

Application No. ~~G-10996~~ Permit No. ~~G-10172~~....
 IN NAME OF

LARRY GRASSMAN

Surveyed Oct. 25, 1984, by Leslie Olson.....