


48579 7761

T41S, R17E, WM6
Scale: 4" = 1 mi.

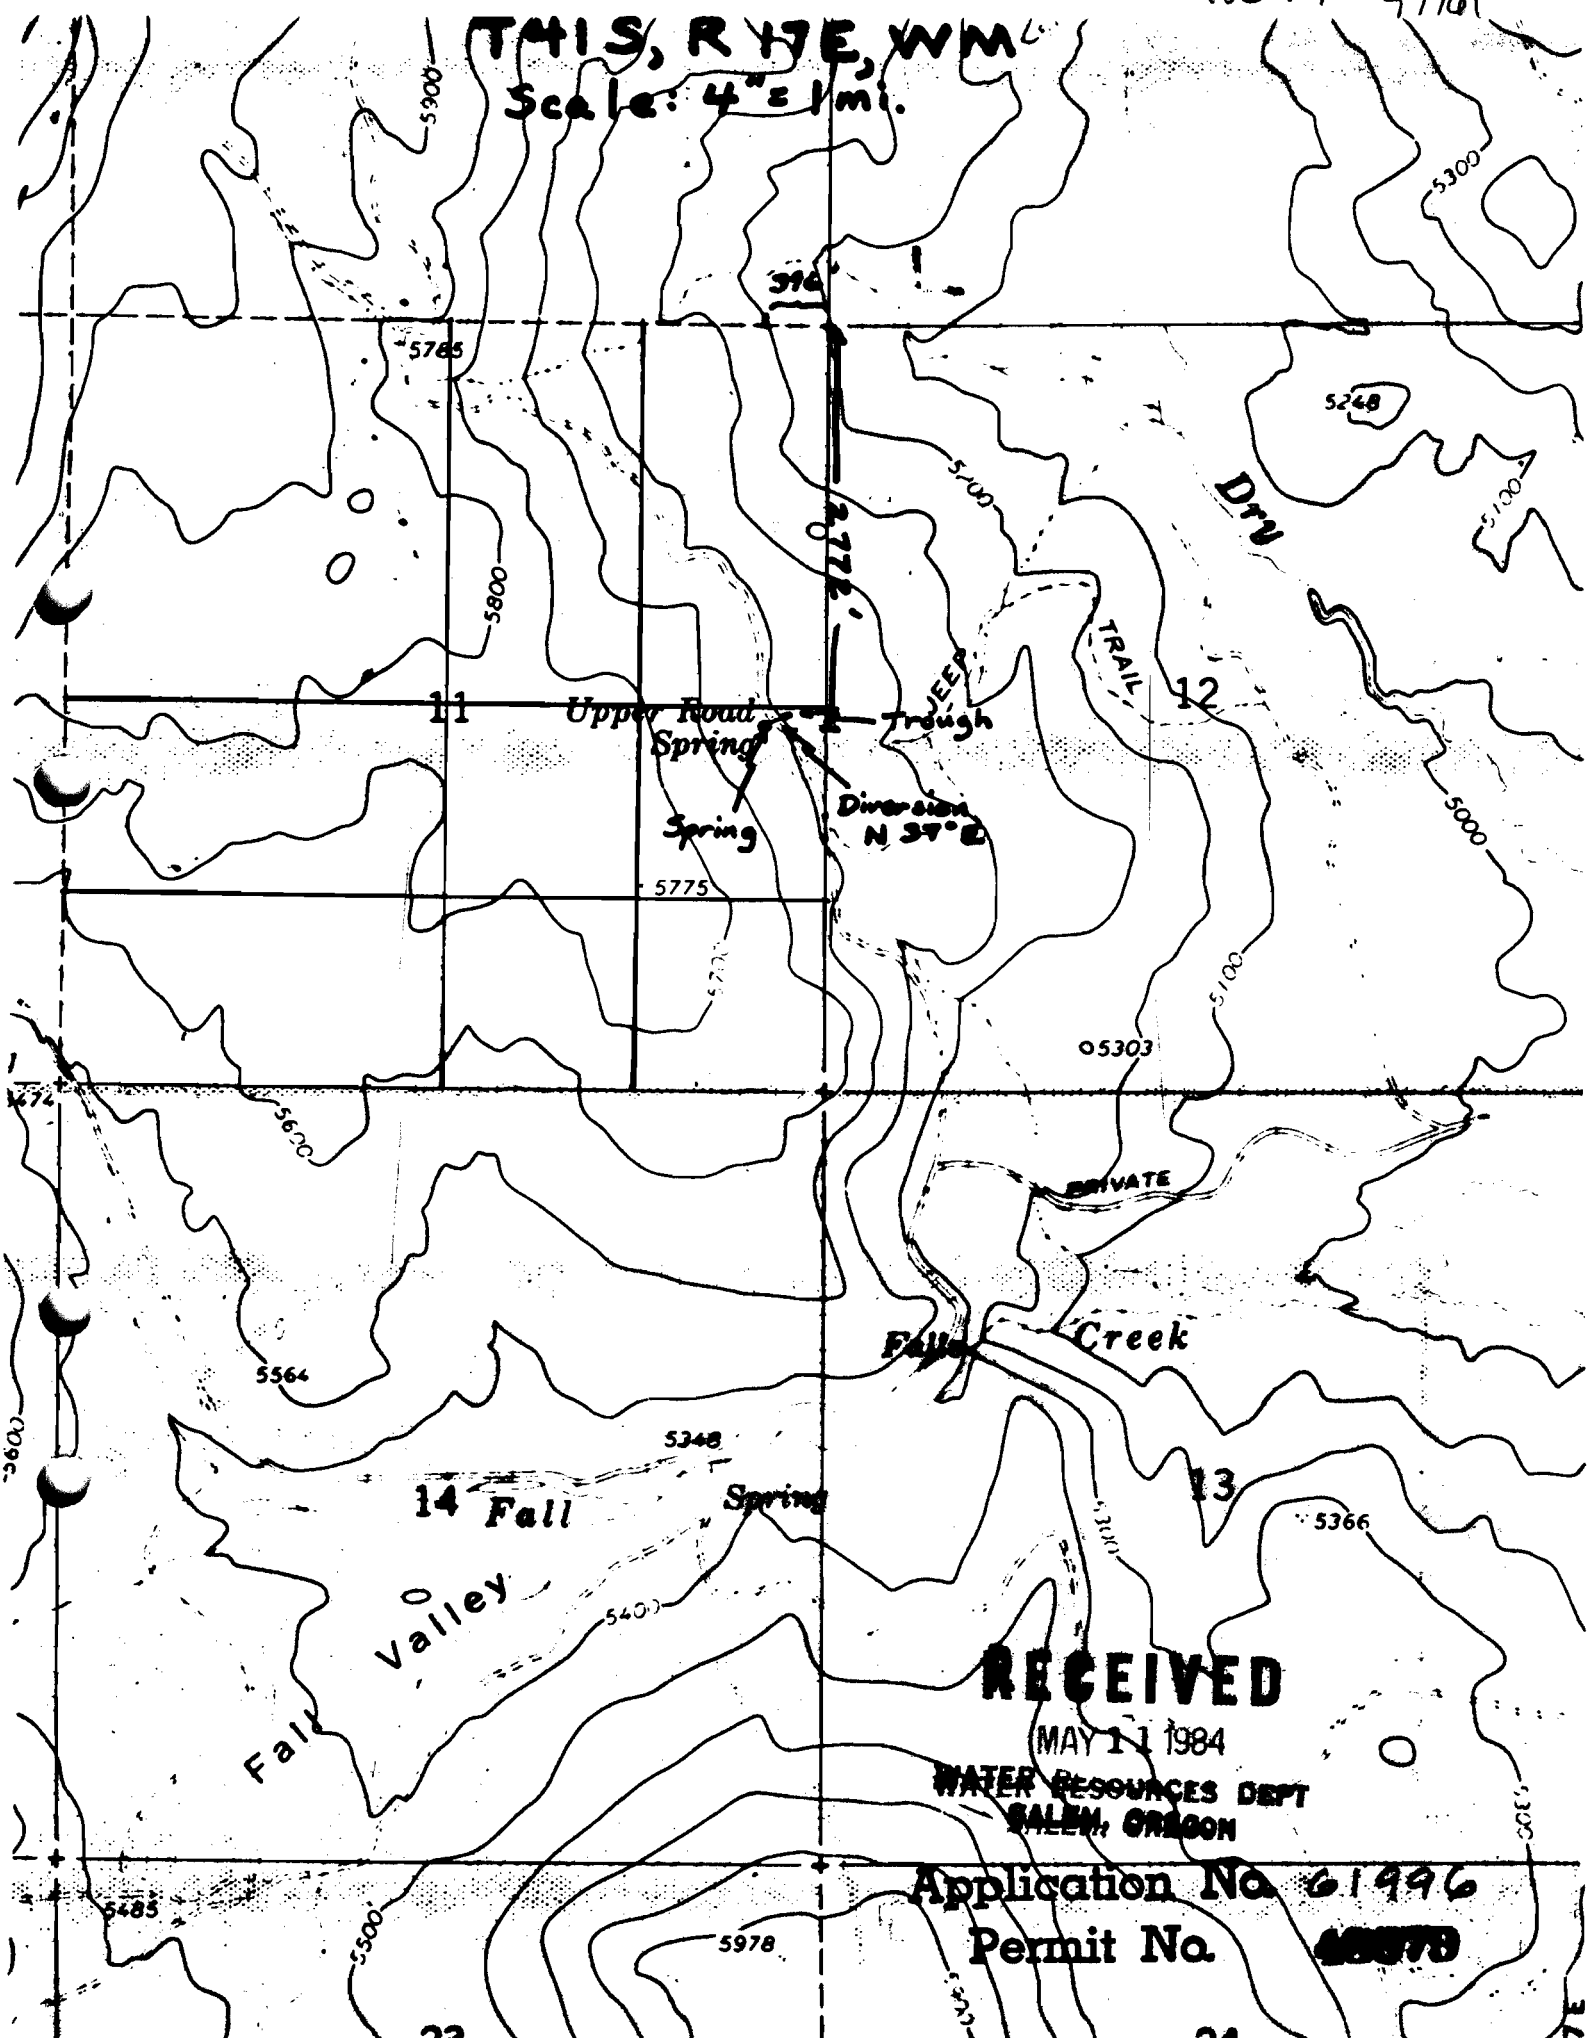

RECEIVED

MAY 11 1984

WATER RESOURCES DEPT
SALEM, OREGON

Application No. 61996

Permit No. 48579

R17E