


T 37 S R 18 E, WM

scale: 4" = 1 mi

48580

77762

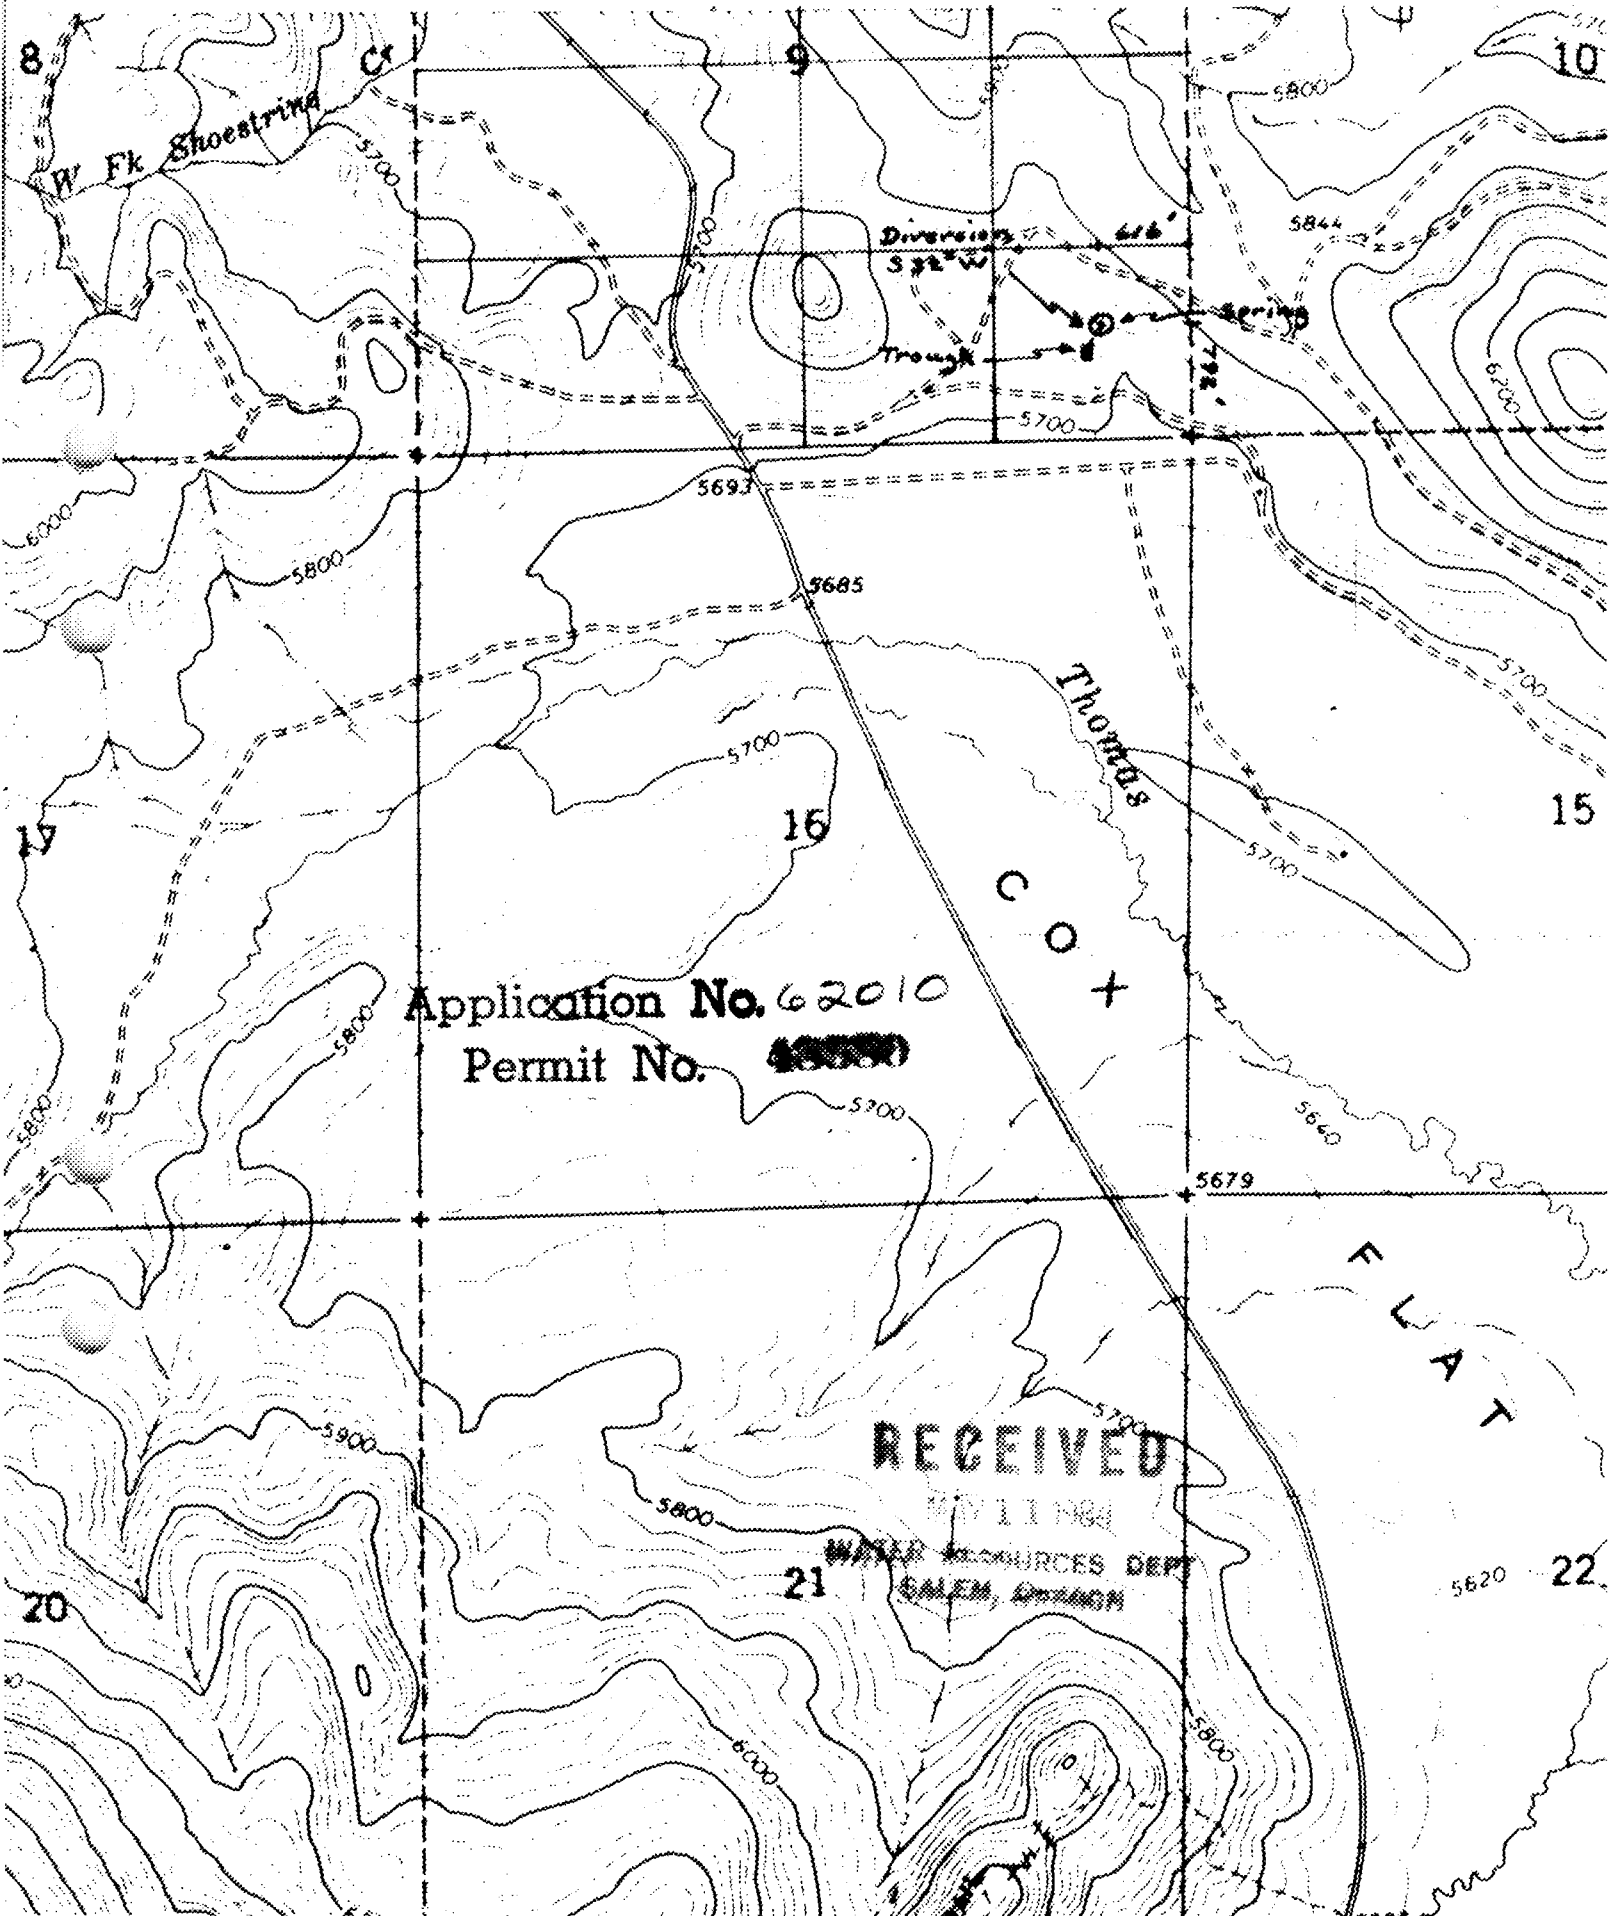

Application No. 62010

Permit No. 48580

RECEIVED

MAY 11 1984

WATER RESOURCES DEPT
SALEM, OREGON