


RECEIVED

SEP 11 1981

WATER RESOURCES DEPT
SALEM, OREGON

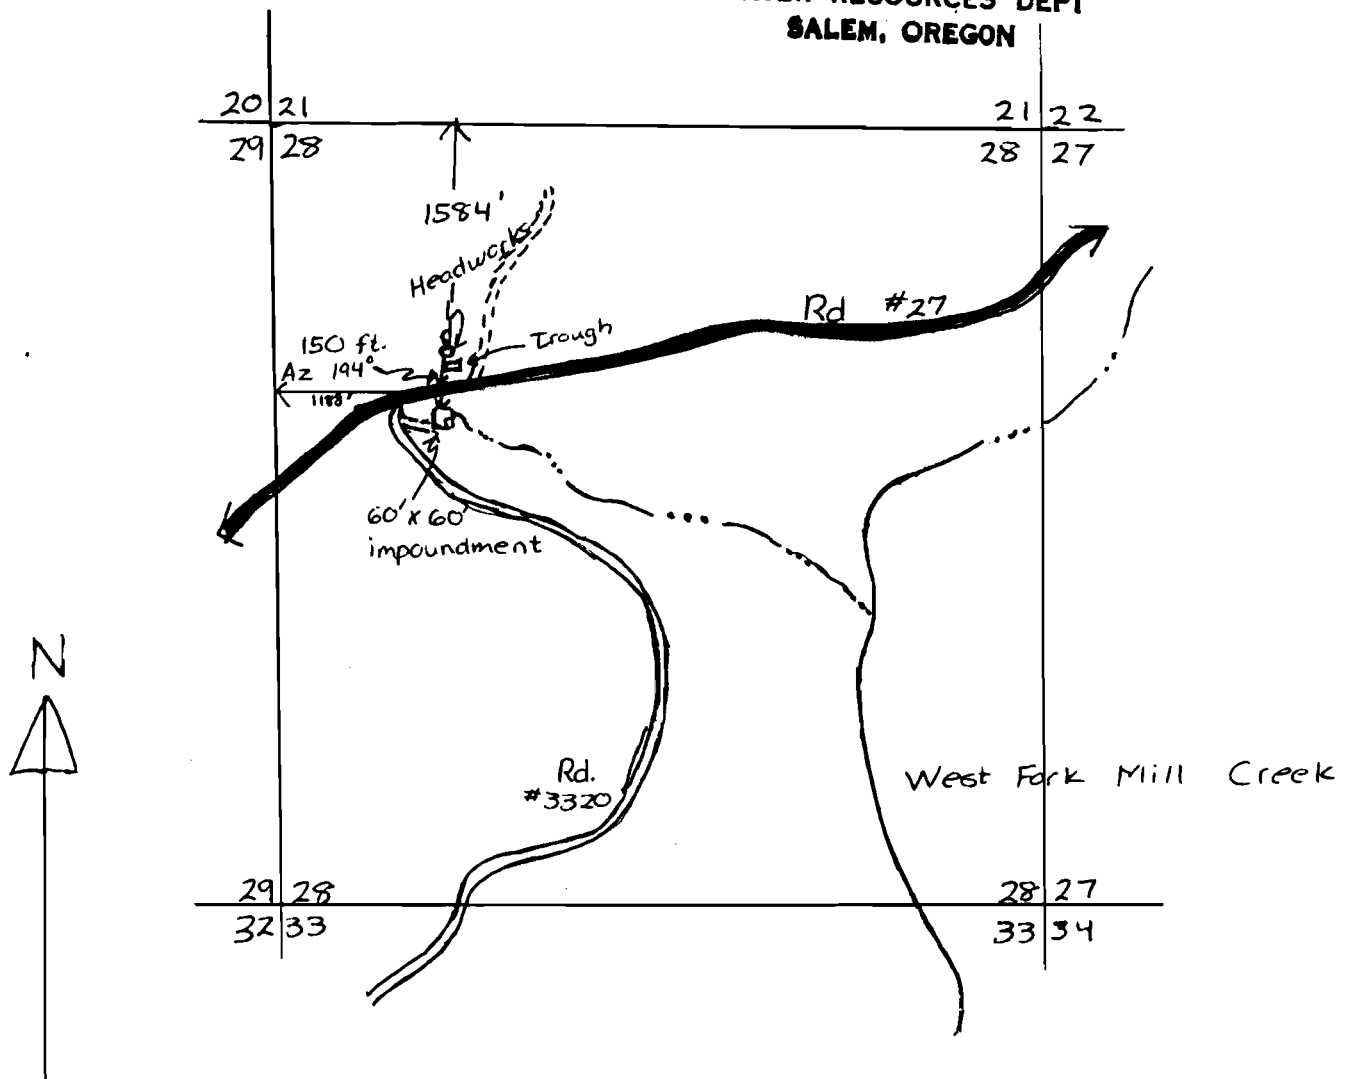

Whiskey Springs

SW $\frac{1}{4}$, NW $\frac{1}{4}$, Sec. 28, T12S, R18E., W.M.

Scale : 4" = 1 mile

Application No. 62718
Permit No. 48651

C-77763

48651