

Map #2

STATE OF OREGON WATER RESOURCES DEPARTMENT
APPLICATION FOR A PERMIT TO APPROPRIATE SURFACE WATER

Application No. 65713
Permit No. 48739

APPLICANT: USDA FOREST SERVICE, MT. HOOD NATIONAL FOREST
2955 N. W. DIVISION ST., GRESHAM, OR 97030

WATER DEVELOPMENT NAME Hidden Spring
LOCATION: Township 1 S Range 10 E Section 2
Ranger District Hood River

RECEIVED


AUG 26 1983

WATER RESOURCES DEPT.
SALEM, OREGON

RECEIVED

MAR 15 1984

WATER RESOURCES DEPT.
SALEM, OREGON

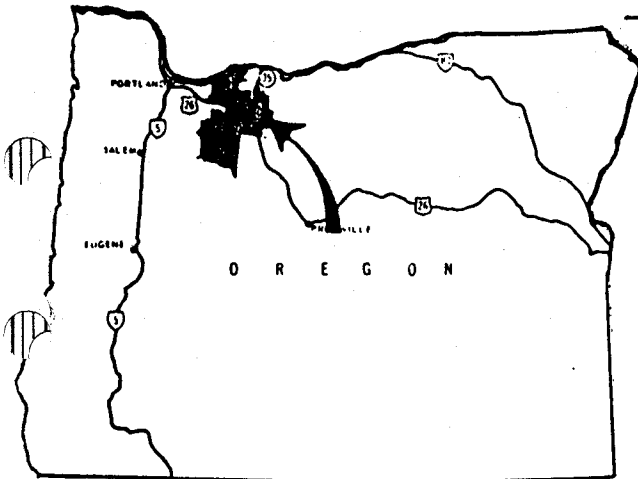



RECEIVED

DEC 1 1983


WATER RESOURCES DEPT.

SALEM, OREGON

TYPICAL POND DEVELOPMENT

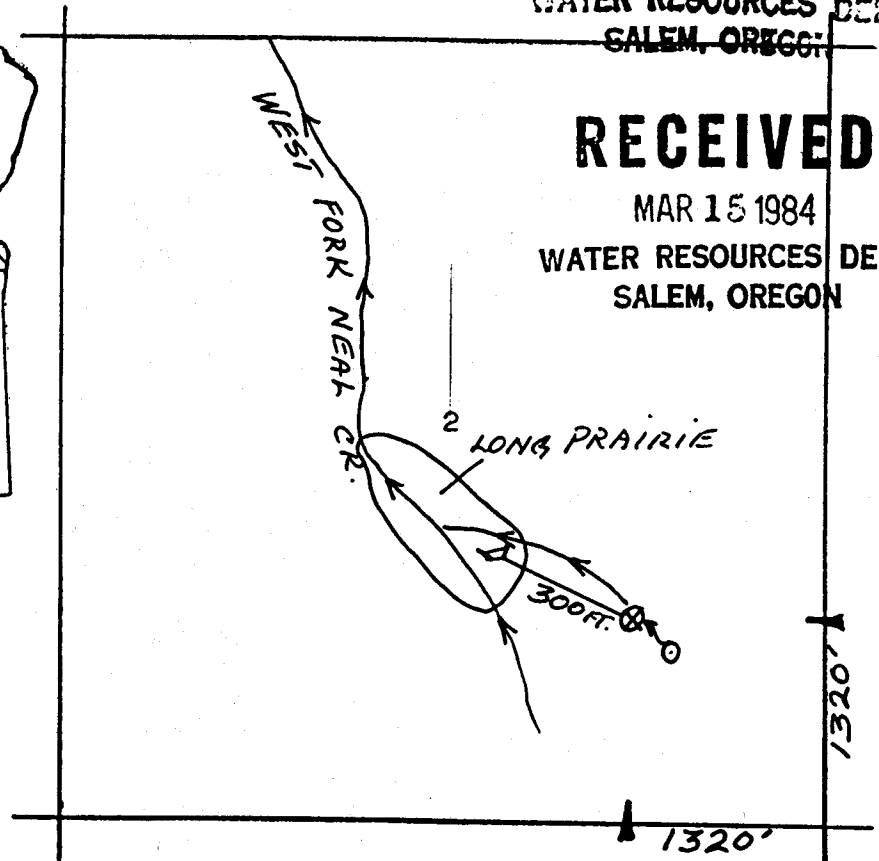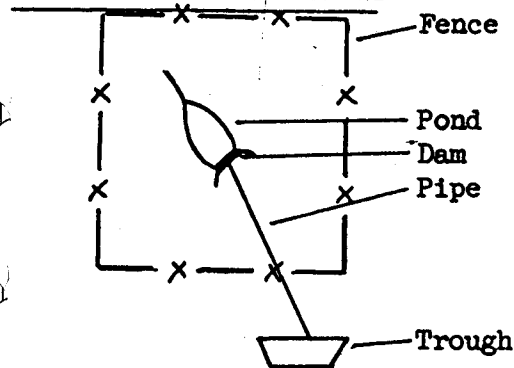

SCALE

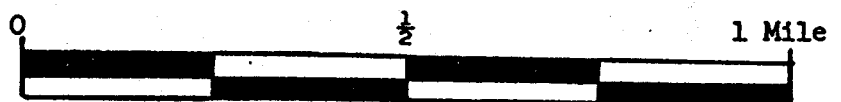


4" to 1 mile

LEGEND

Intermittant Stream	→ ... →
Perennial Stream	→ → →
Flow Direction	→ → →
Road	==
Exclosure Fence	— X — X —
Pond	∩
Spring	⊙

TYPICAL SPRING DEVELOPMENT

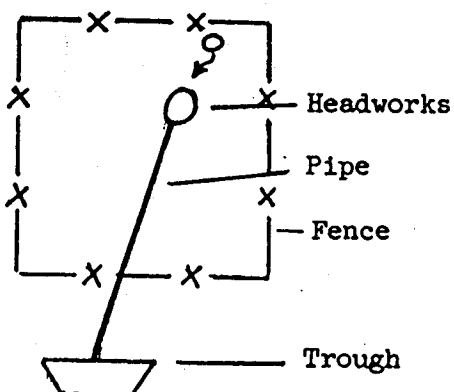

STATE OF OREGON WATER RESOURCES DEPARTMENT
APPLICATION FOR A PERMIT TO APPROPRIATE SURFACE WATER

Application No. 6573
Permit No. 48739

APPLICANT: USDA FOREST SERVICE, MT. HOOD NATIONAL FOREST
2955 N. W. DIVISION ST., GRESHAM, OR 97030

WATER DEVELOPMENT NAME JOE'S SPRING



LOCATION: Township 1 S Range 10 E Section 2

Ranger District HOOD RIVER

RECEIVED

AUG 26 1983

WATER RESOURCES DEPT.
SALEM, OREGON

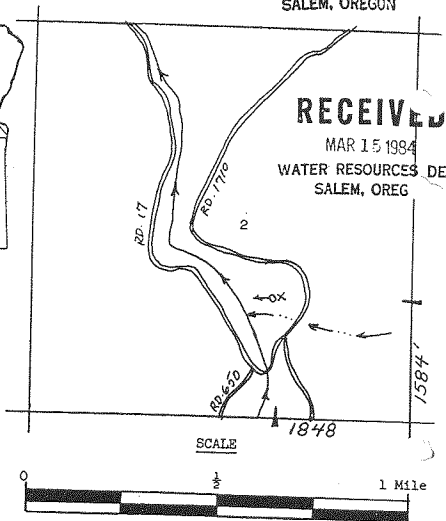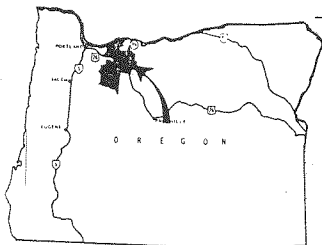


RECEIVED


MAR 15 1984

WATER RESOURCES DEPT.
SALEM, OREG

TYPICAL POND DEVELOPMENT

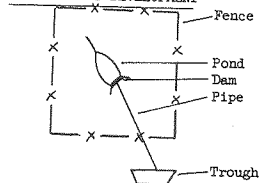

TYPICAL SPRING DEVELOPMENT

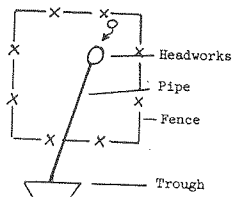

LEGEND

- Intermittant Stream
- Perennial Stream
- Flow Direction
- Road
- Exclosure Fence
- Pond
- Spring

8/5/83