


RECEIVED

SEP 11 1981

WATER RESOURCES DEPT
SALEM, OREGON

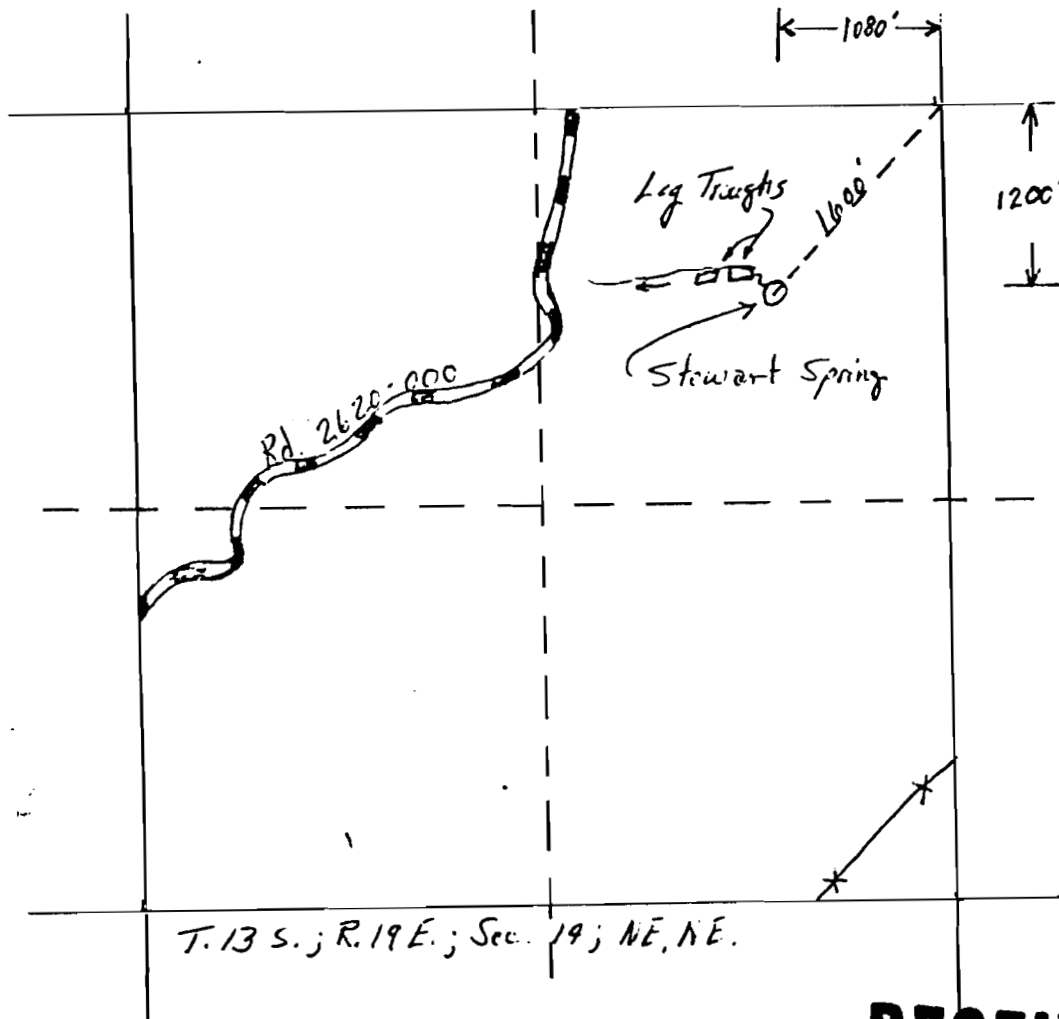

SCALE: 4 Inches = 1 Mile

NORTH

Application No. 62673
Permit No. 48838



RECEIVED

AUG 8 1983

WATER RESOURCES DEPT.
SALEM, OREGON

C-77769

48838