


6462

9727

SW ¹/₄ Sec 30, T27R11E W.M

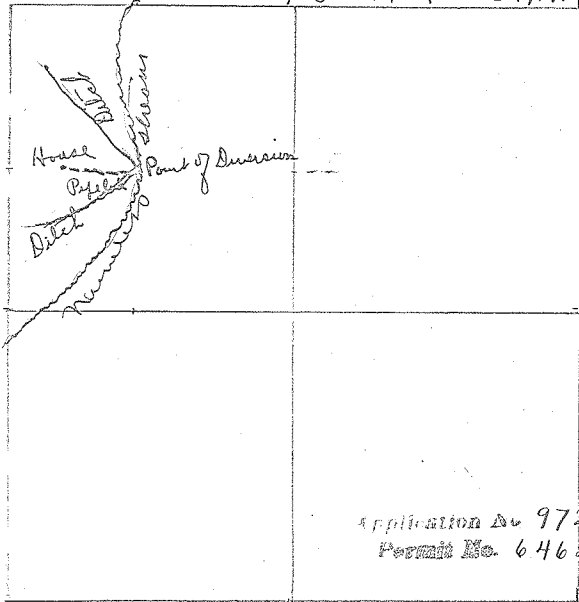

Application No. 9727
Permit No. 6462