


SEP 11 1981
WATER RESOURCES DEPT
SALEM, OREGON

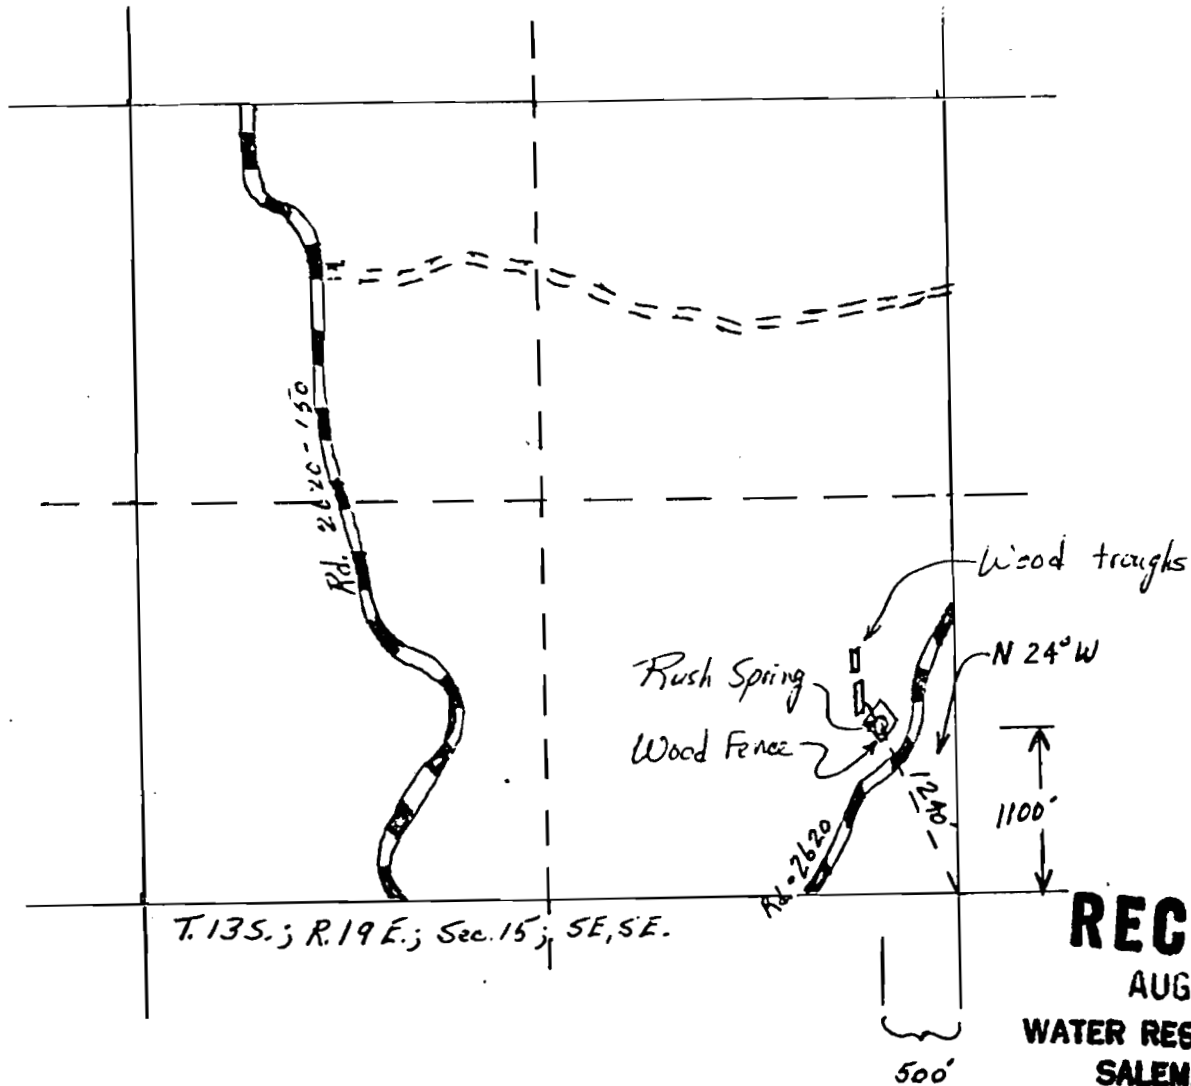

RECEIVED
AUG 8 1983
WATER RESOURCES DEPT.
SALEM, OREGON

SCALE: 4 Inches = 1 Mile

NORTH



Application No. C 2674

Permit No. 48839

C-77770

48839