


SEP 11 1981
WATER RESOURCES DEPT
SALEM, OREGON

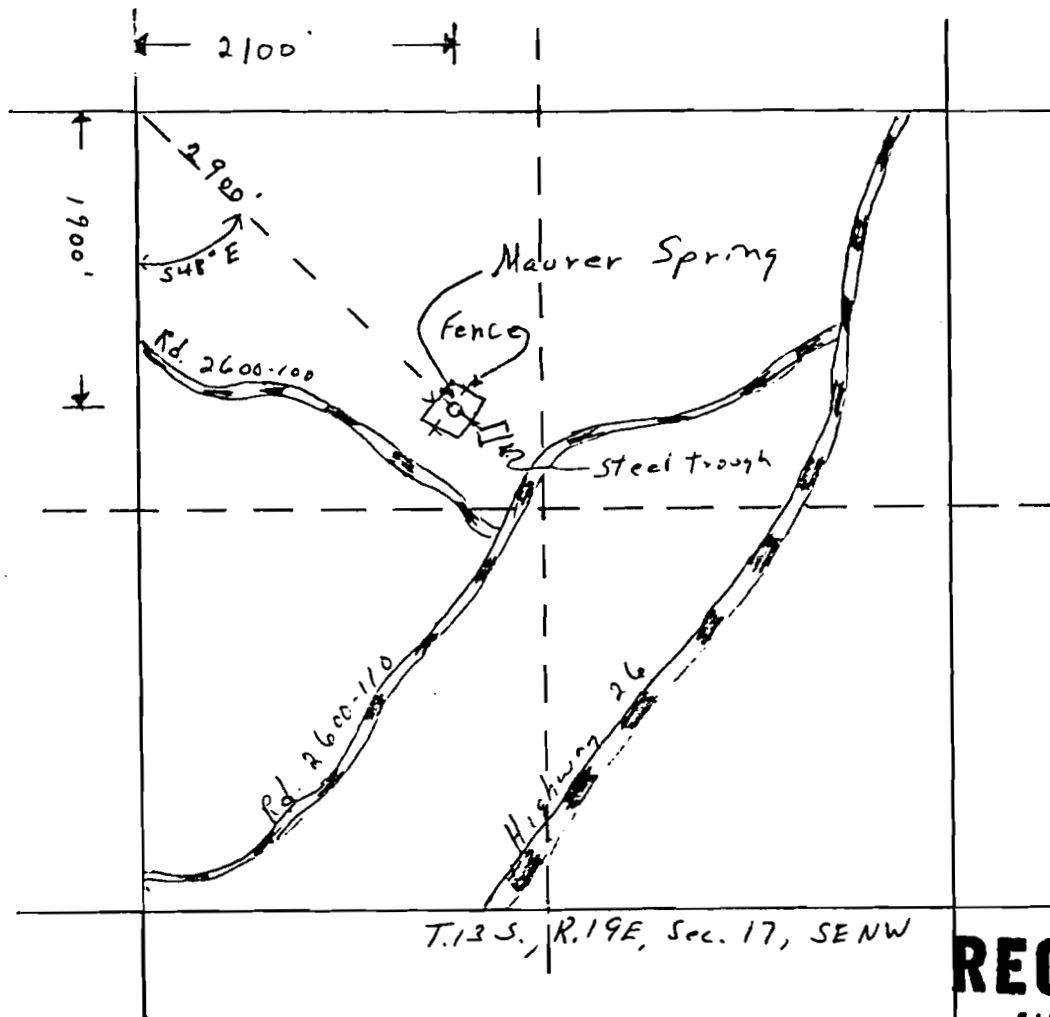

T.13S, R.19E, Sec. 17, SE NW

RECEIVED

AUG 8 1983

WATER RESOURCES DEPT.
SALEM, OREGON

SCALE: 4 Inches = 1 Mile

NORTH



Application No. 62675
Permit No. 48840

C-77771

48840