


RECEIVED

SEP 11 1981

WATER RESOURCES DEPT
SALEM, OREGON

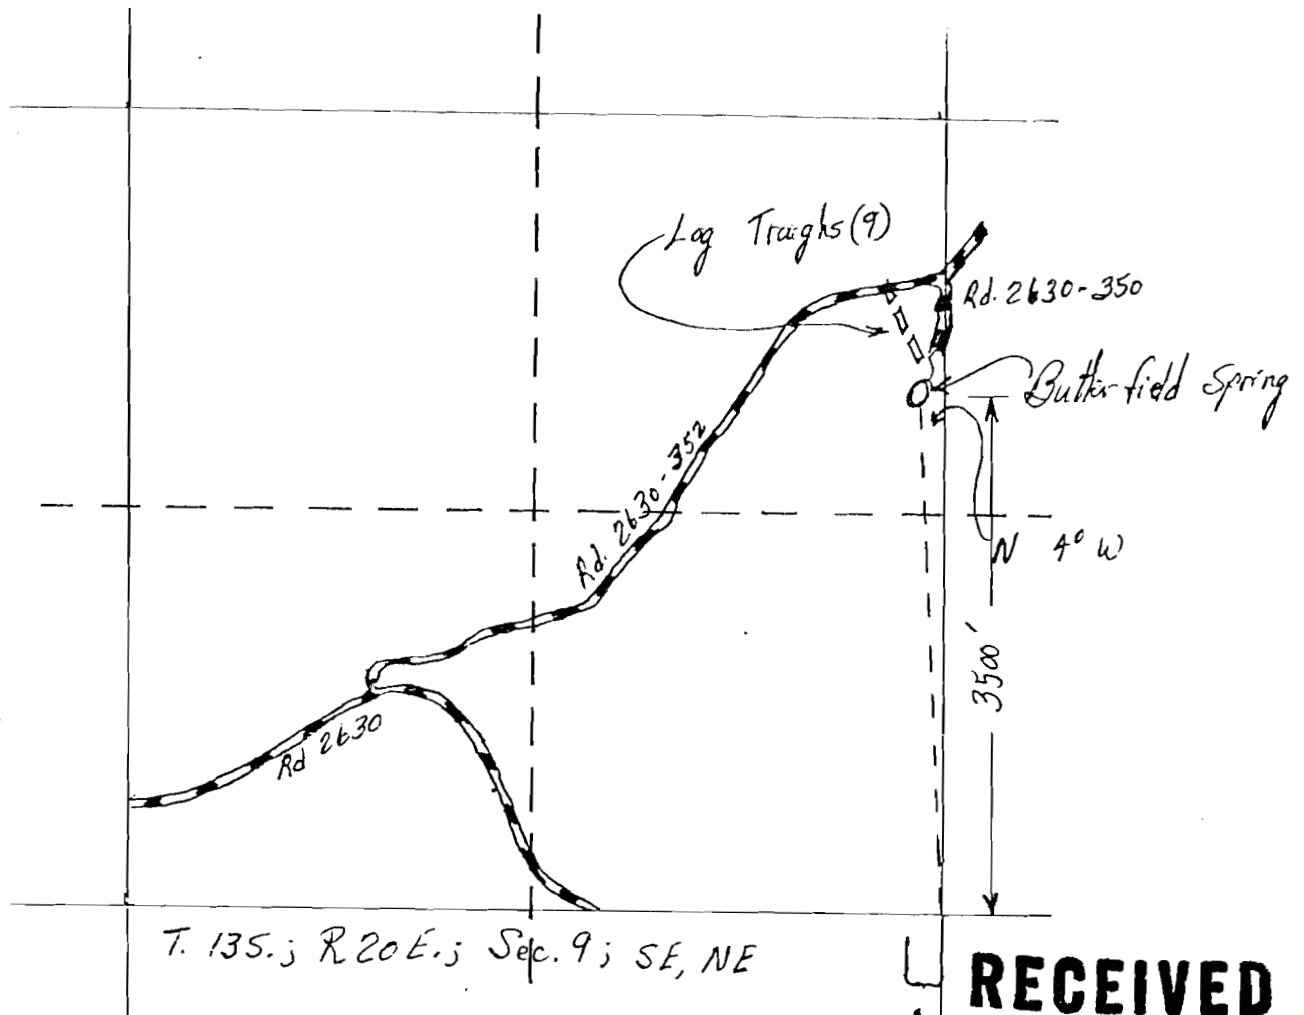

T. 135.; R 20 E.; Sec. 9; SE, NE

SCALE: 4 Inches = 1 Mile

NORTH



Application No. 02679

Permit No. 48844

RECEIVED

AUG 8 1983

WATER RESOURCES DEPT.
SALEM, OREGON

JC 7/29/80