


RECEIVED

SEP 11 1981

WATER RESOURCES DEPT
SALEM, OREGON

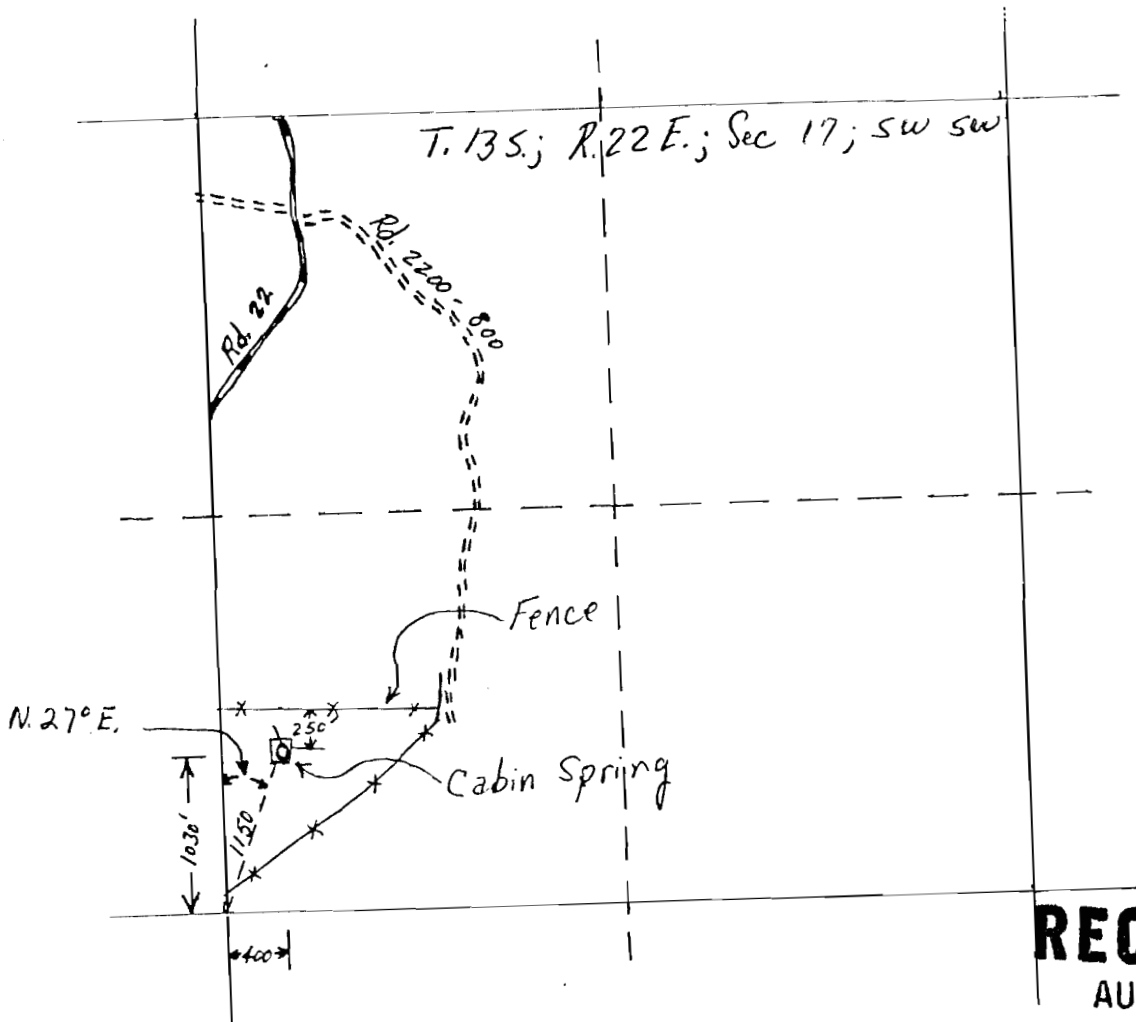

RECEIVED

AUG 8 1983

WATER RESOURCES DEPT.
SALEM, OREGON

SCALE: 4 Inches = 1 Mile

NORTH



Application No. 62680

Permit No. 48845