


RECEIVED
SEP 11 1981
WATER RESOURCES DEPT
SALEM, OREGON

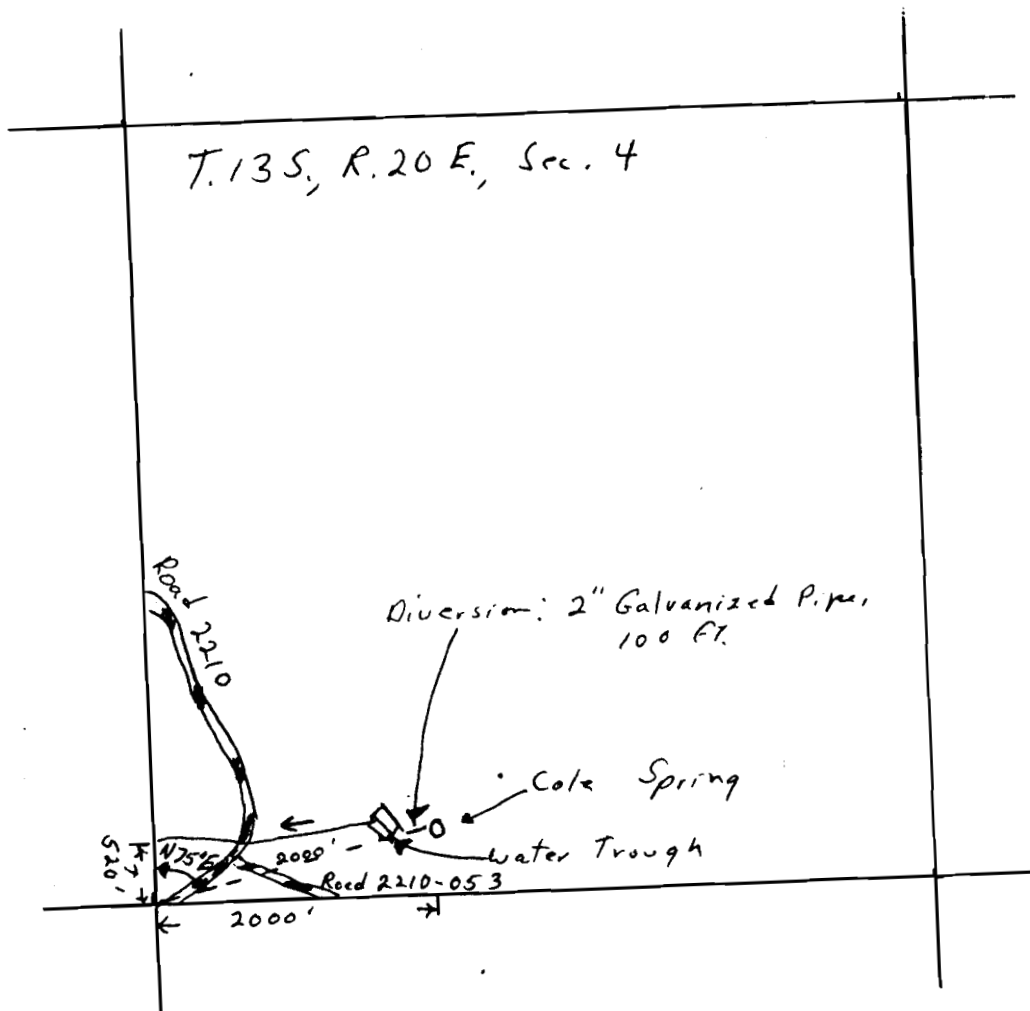

SCALE: 4 Inches = 1 Mile

NORTH



Application No. 62683

Permit No. 48848

C-77777

48848