


RECEIVED

SEP 11 1981

WATER RESOURCES DEPT
SALEM, OREGON

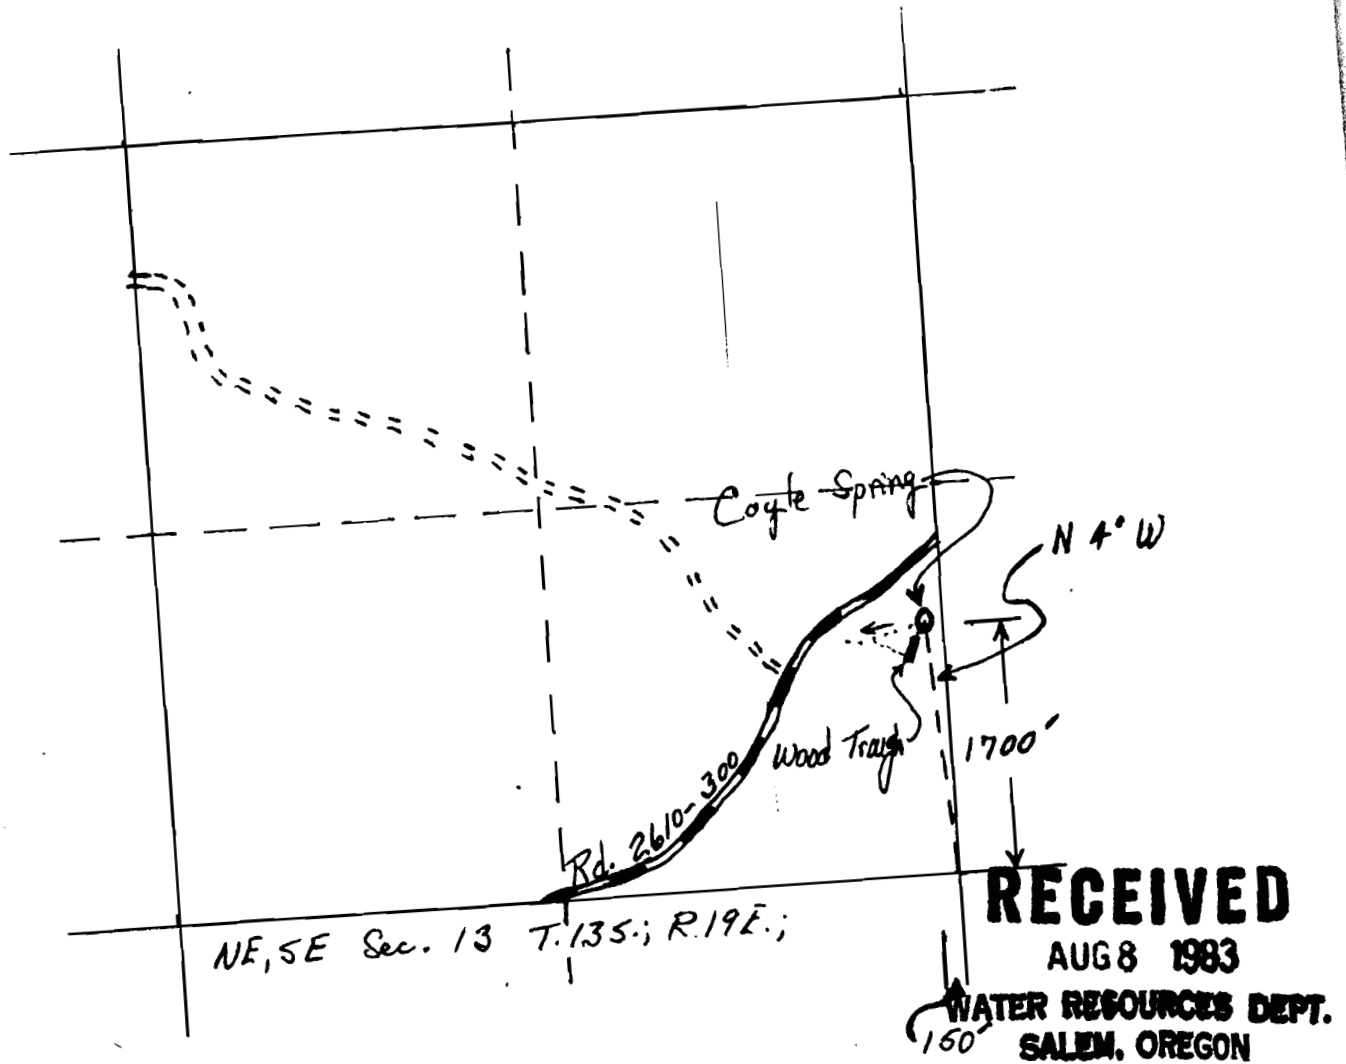

SCALE: 4 Inches = 1 Mile

NORTH



Application No. 62684
Permit No. 48849

C-77778

48849