


RECEIVED

SEP 11 1981

WATER RESOURCES DEPT
SALEM, OREGON

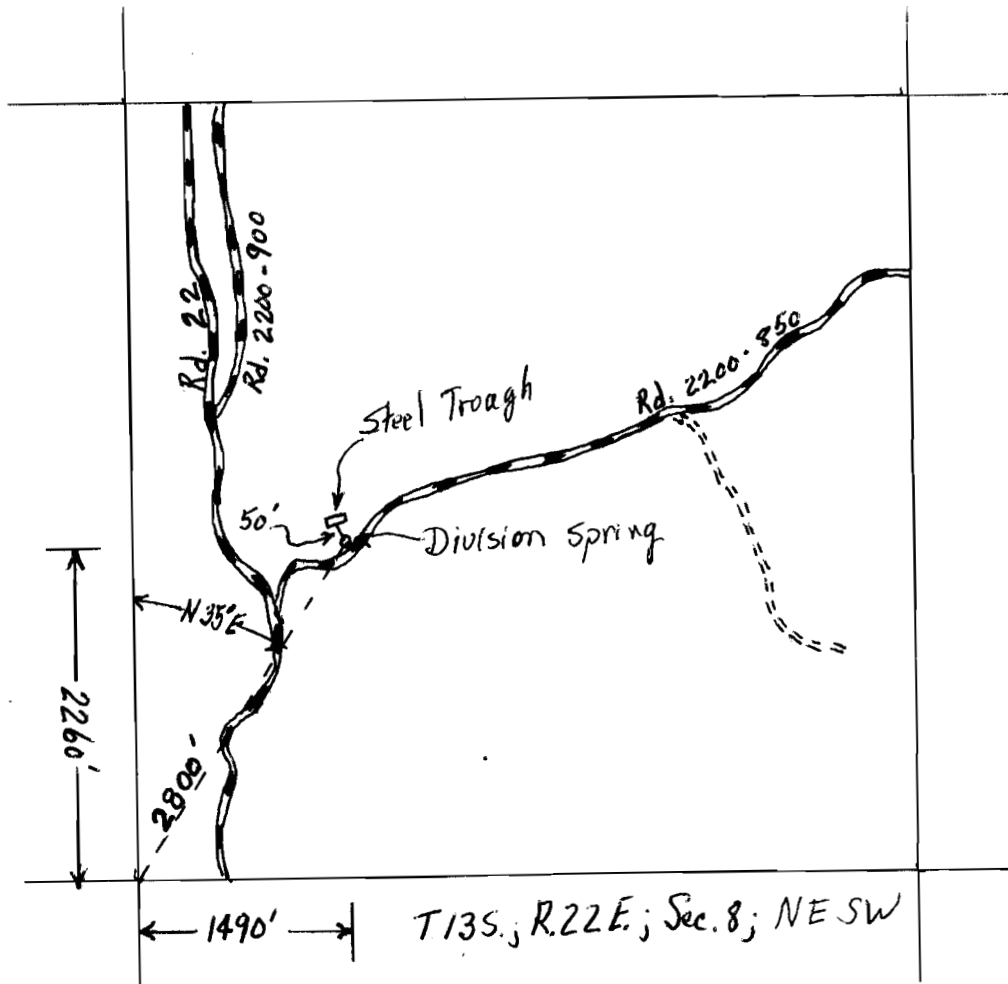

SCALE: 4 Inches = 1 Mile

NORTH



Application No. 02687
Permit No. 48852