RECEIVED
SEP 11 1981
WATER RESOURCES DEPT
SALEM, OREGON

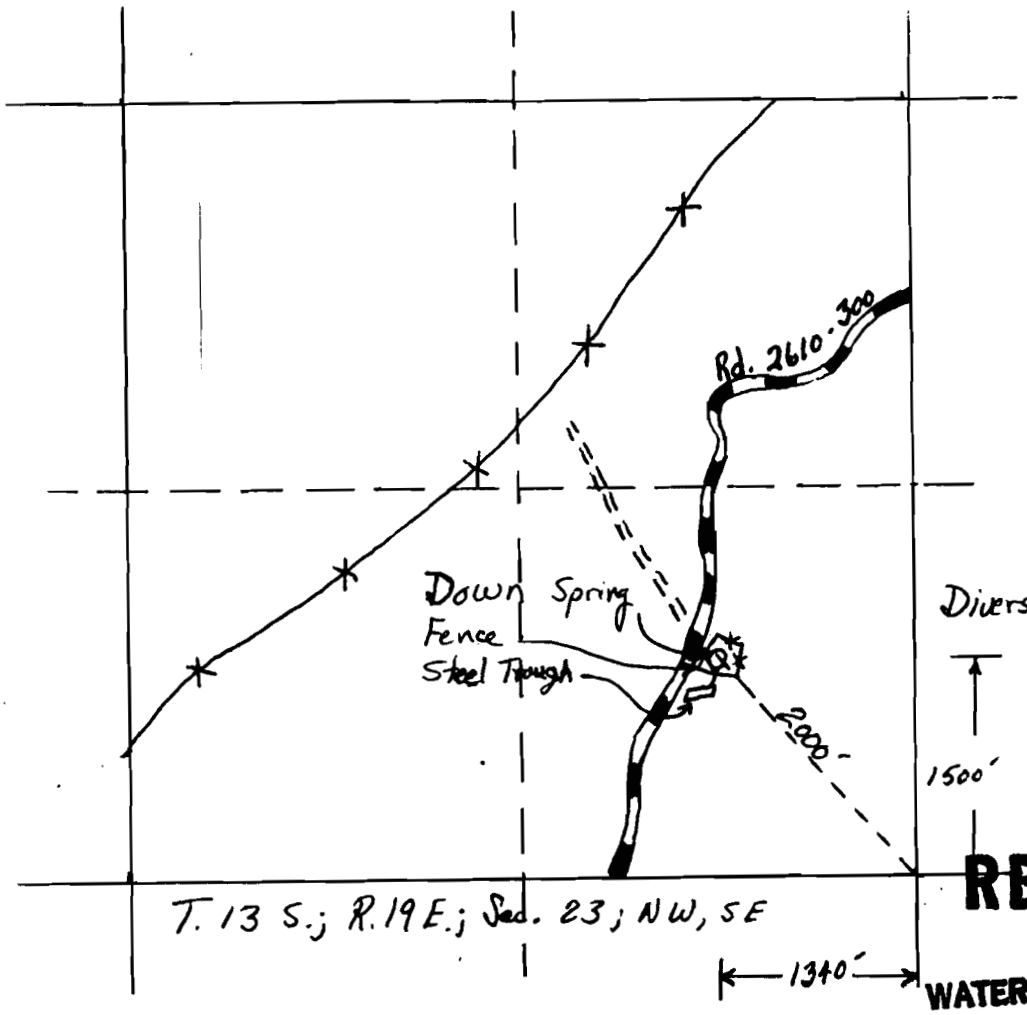

Diversion: 25' 1¼" plastic pipe from spring to trough, connected to 20' 1" steel pipe.

RECEIVED
AUG 8 1983
WATER RESOURCES DEPT.
SALEM, OREGON

SCALE: 4 Inches = 1 Mile

NORTH

Application No. G-2688

Permit No. 48853

JG

C-7778!

48853