


RECEIVED

SEP 11 1981

WATER RESOURCES DEPT  
SALEM, OREGON

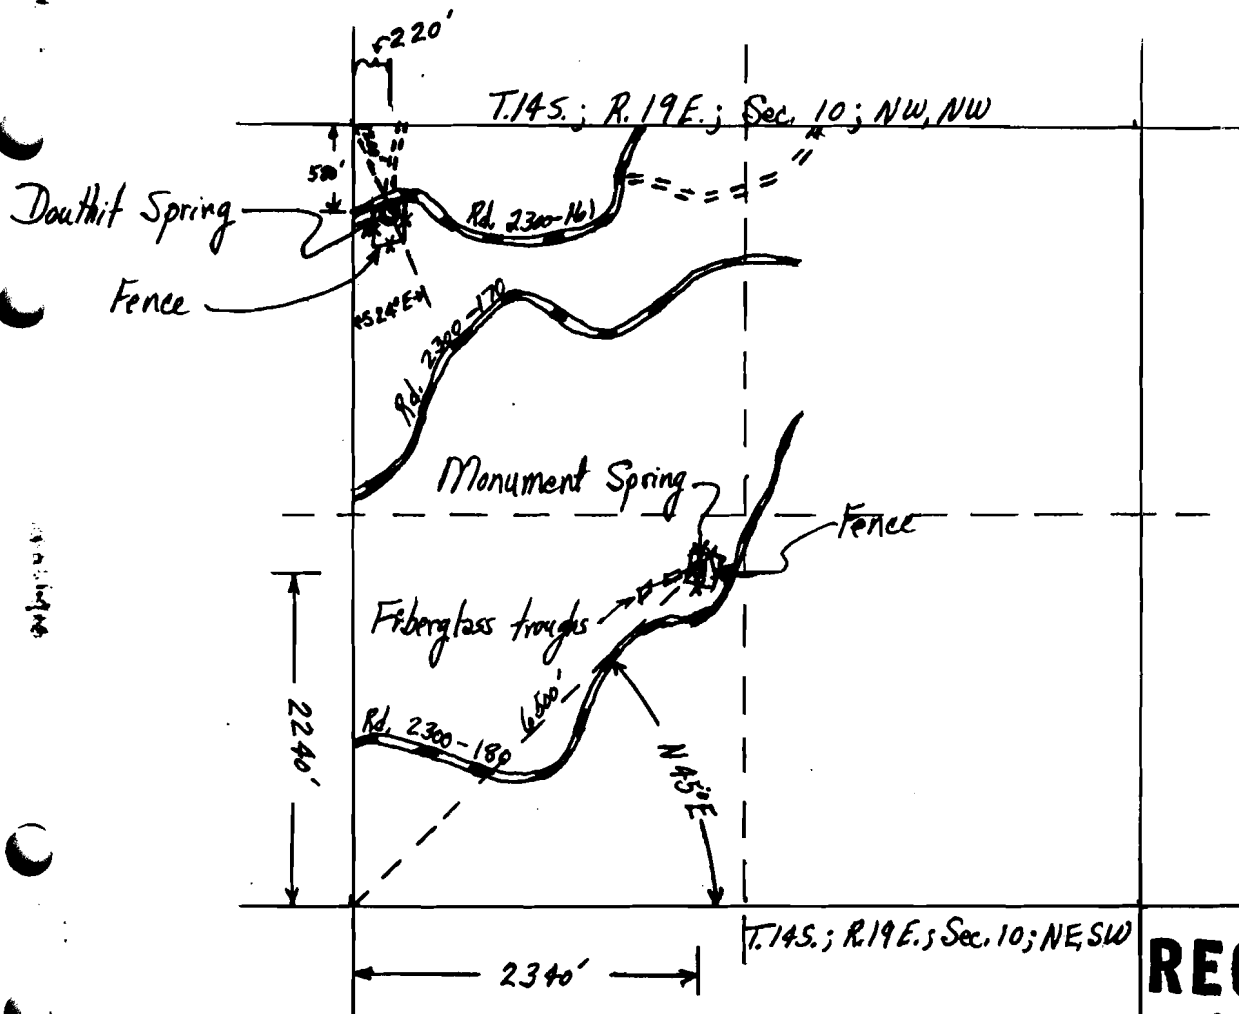

SCALE: 4 Inches = 1 Mile

NORTH



Application No. 62691  
Permit No. 48856

RECEIVED

AUG 8 1983

WATER RESOURCES DEPT.  
SALEM, OREGON

C-77784

48856