


RECEIVED

SEP 11 1981

WATER RESOURCES DEPT
SALEM, OREGON

Application No. 62692
Permit No. 48857

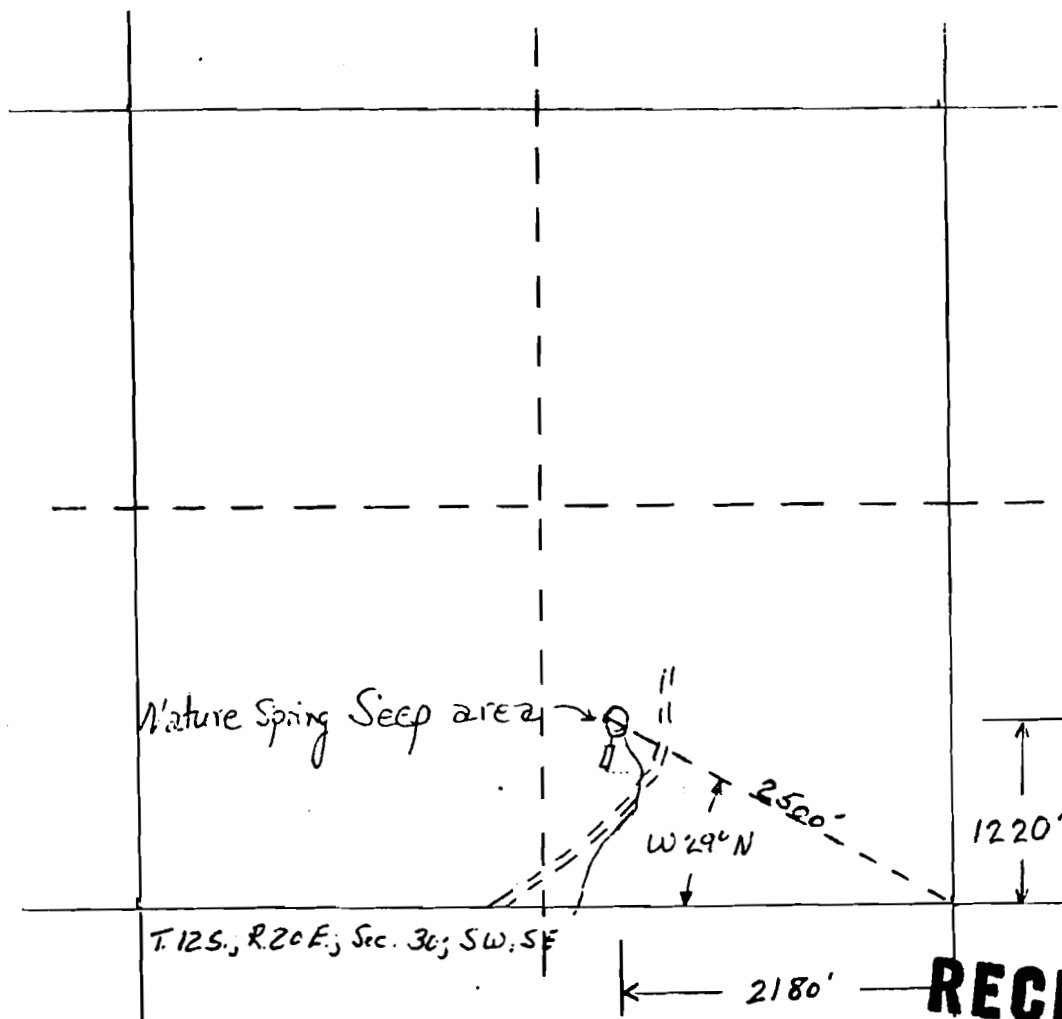

T. 12S., R. 20E., Sec. 30; SW, SE

2180'

1220'

RECEIVED

AUG 8 1983

WATER RESOURCES DEPT.
SALEM, OREGON

SCALE: 4 Inches = 1 Mile

NORTH



C-77785

48857