


RECEIVED

SEP 11 1981

WATER RESOURCES DEPT
SALEM, OREGON

Application No. 62693

Permit No. 48858

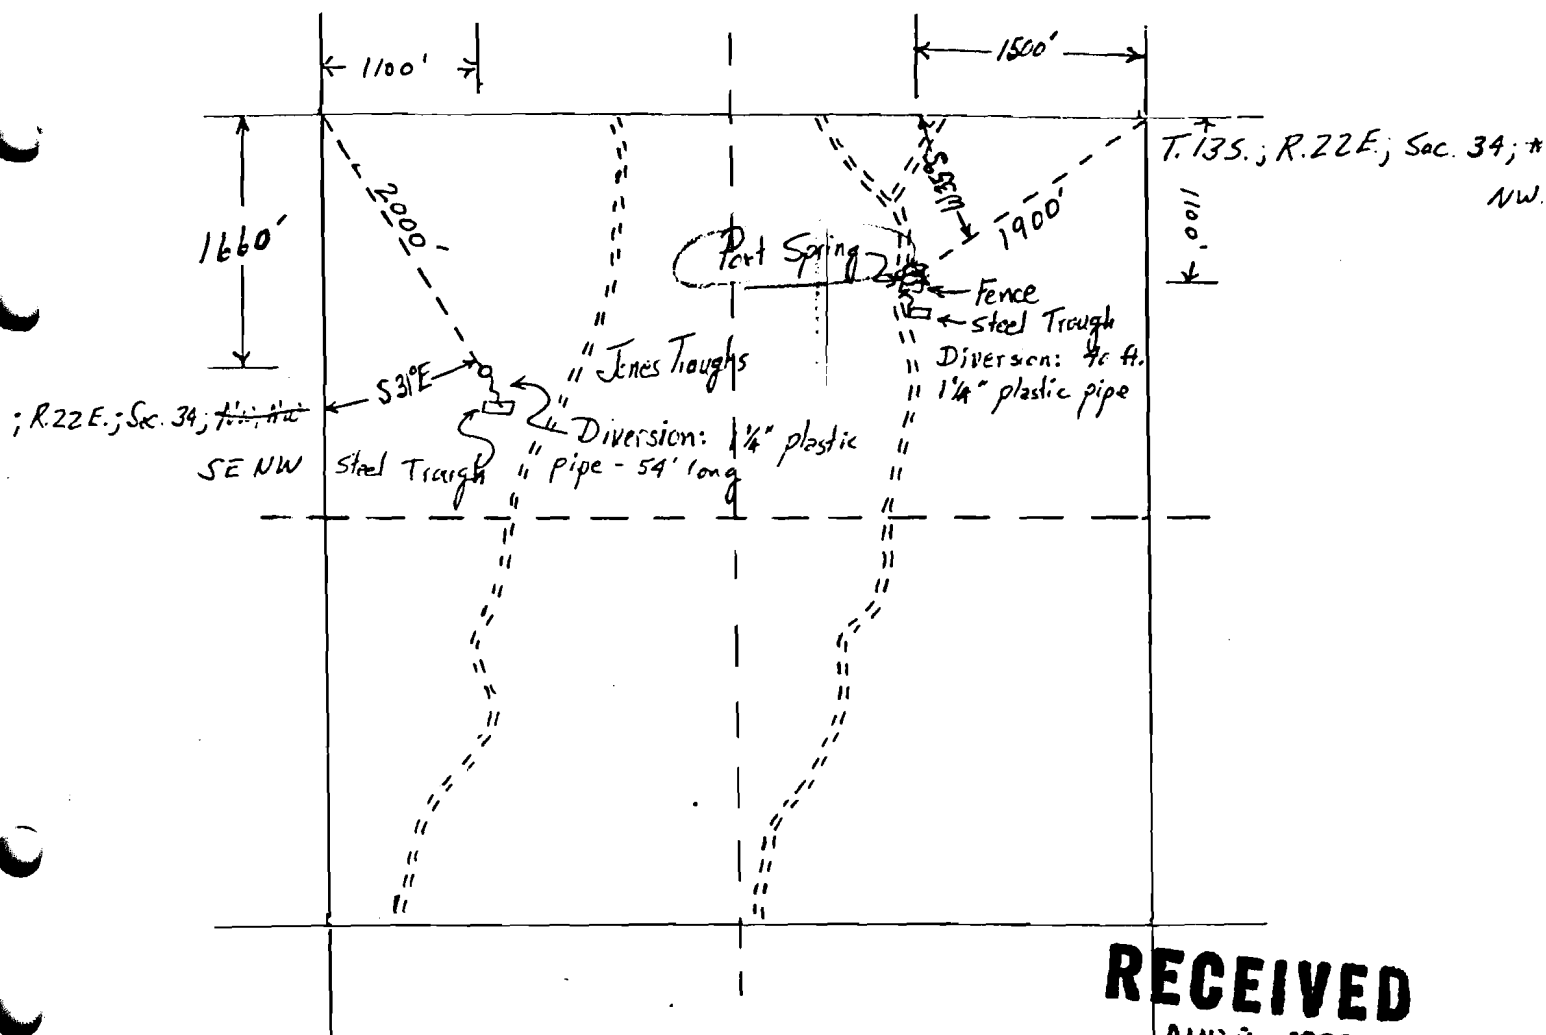

RECEIVED

AUG 8 1983

WATER RESOURCES DEPT.
SALEM, OREGON

SCALE: 4 Inches = 1 Mile

NORTH



C-77786

48858