


RECEIVED

SEP 11 1981

WATER RESOURCES DEPT
SALEM, OREGON

Application No. 62694
Permit No. 48859

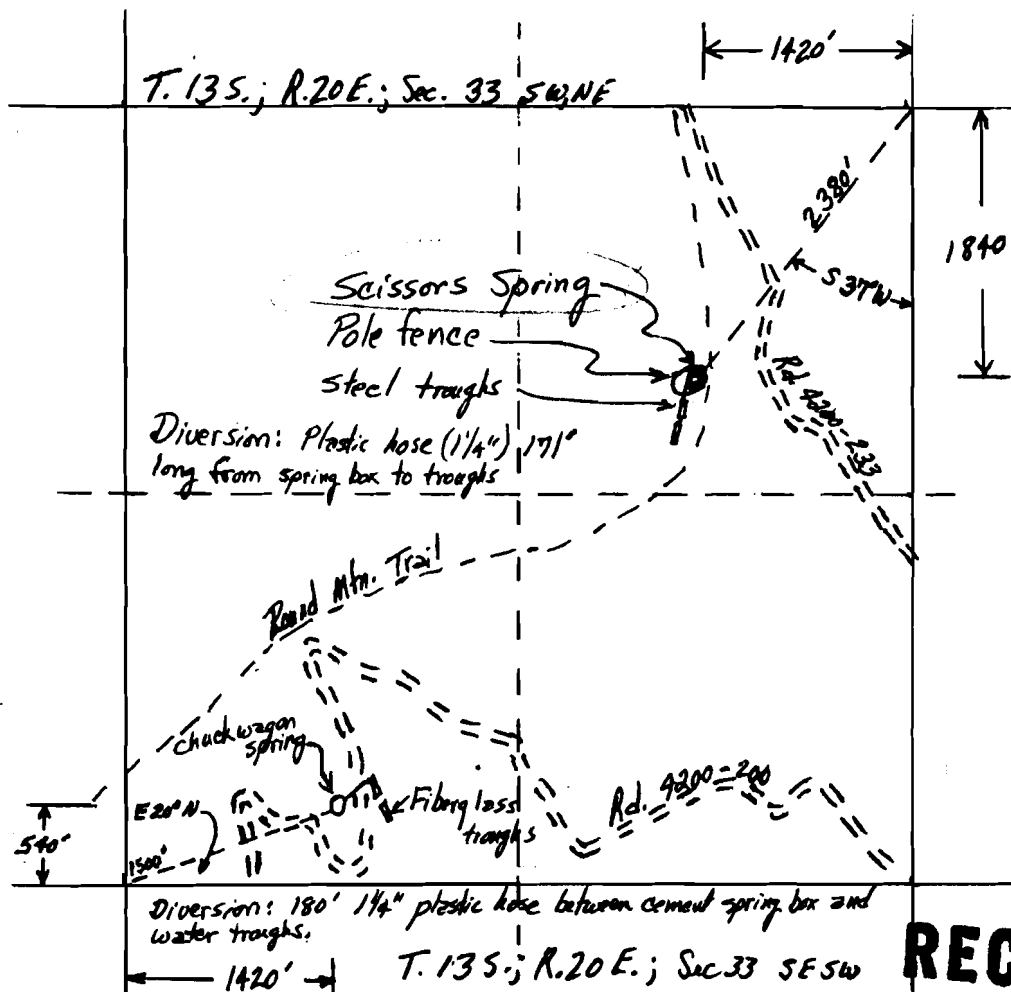

SCALE: 4 Inches = 1 Mile

NORTH



RECEIVED

AUG 8 1983

WATER RESOURCES DEPT.
SALEM, OREGON

C-77787

48859