


SEP 11 1981

Application No. 62695
Permit No. 48860

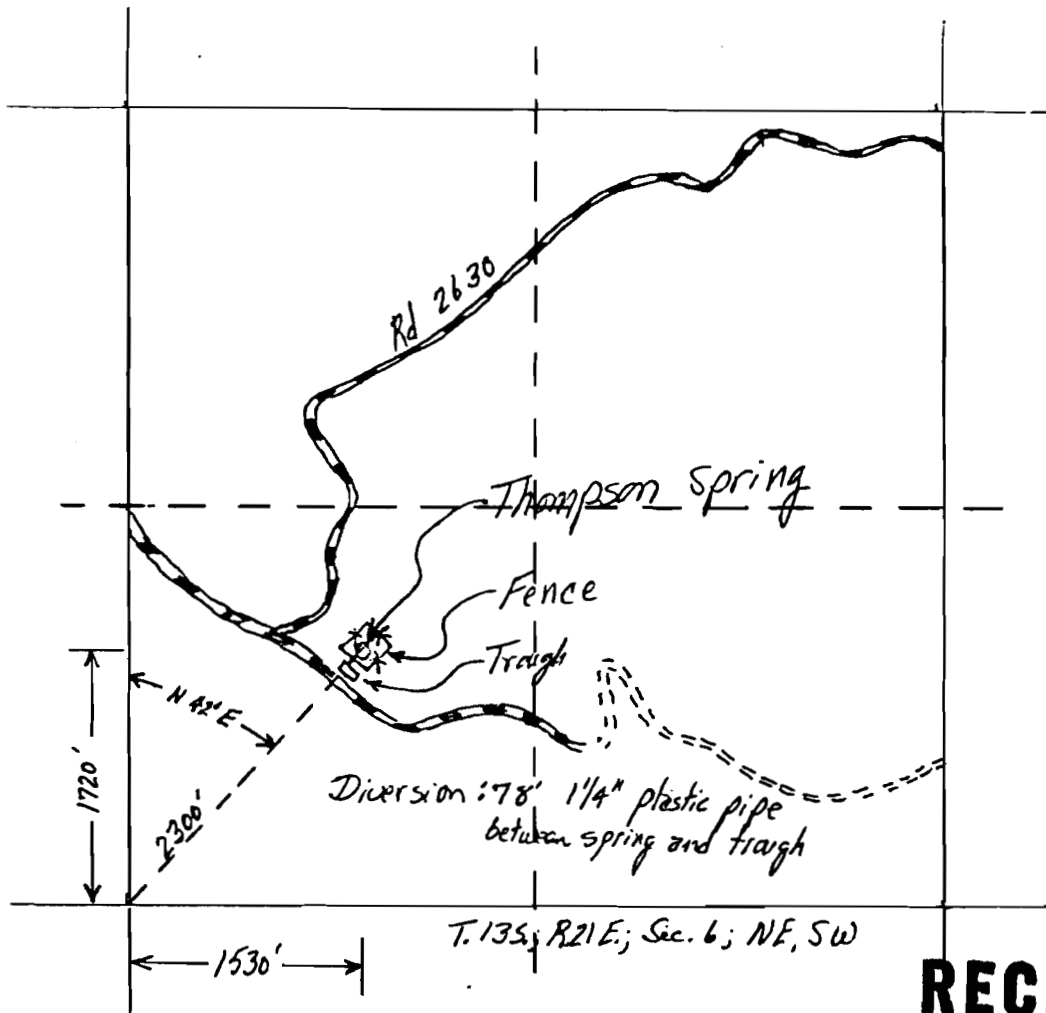

NORTH



AUG 8 1983

C-77788

JG
48860