


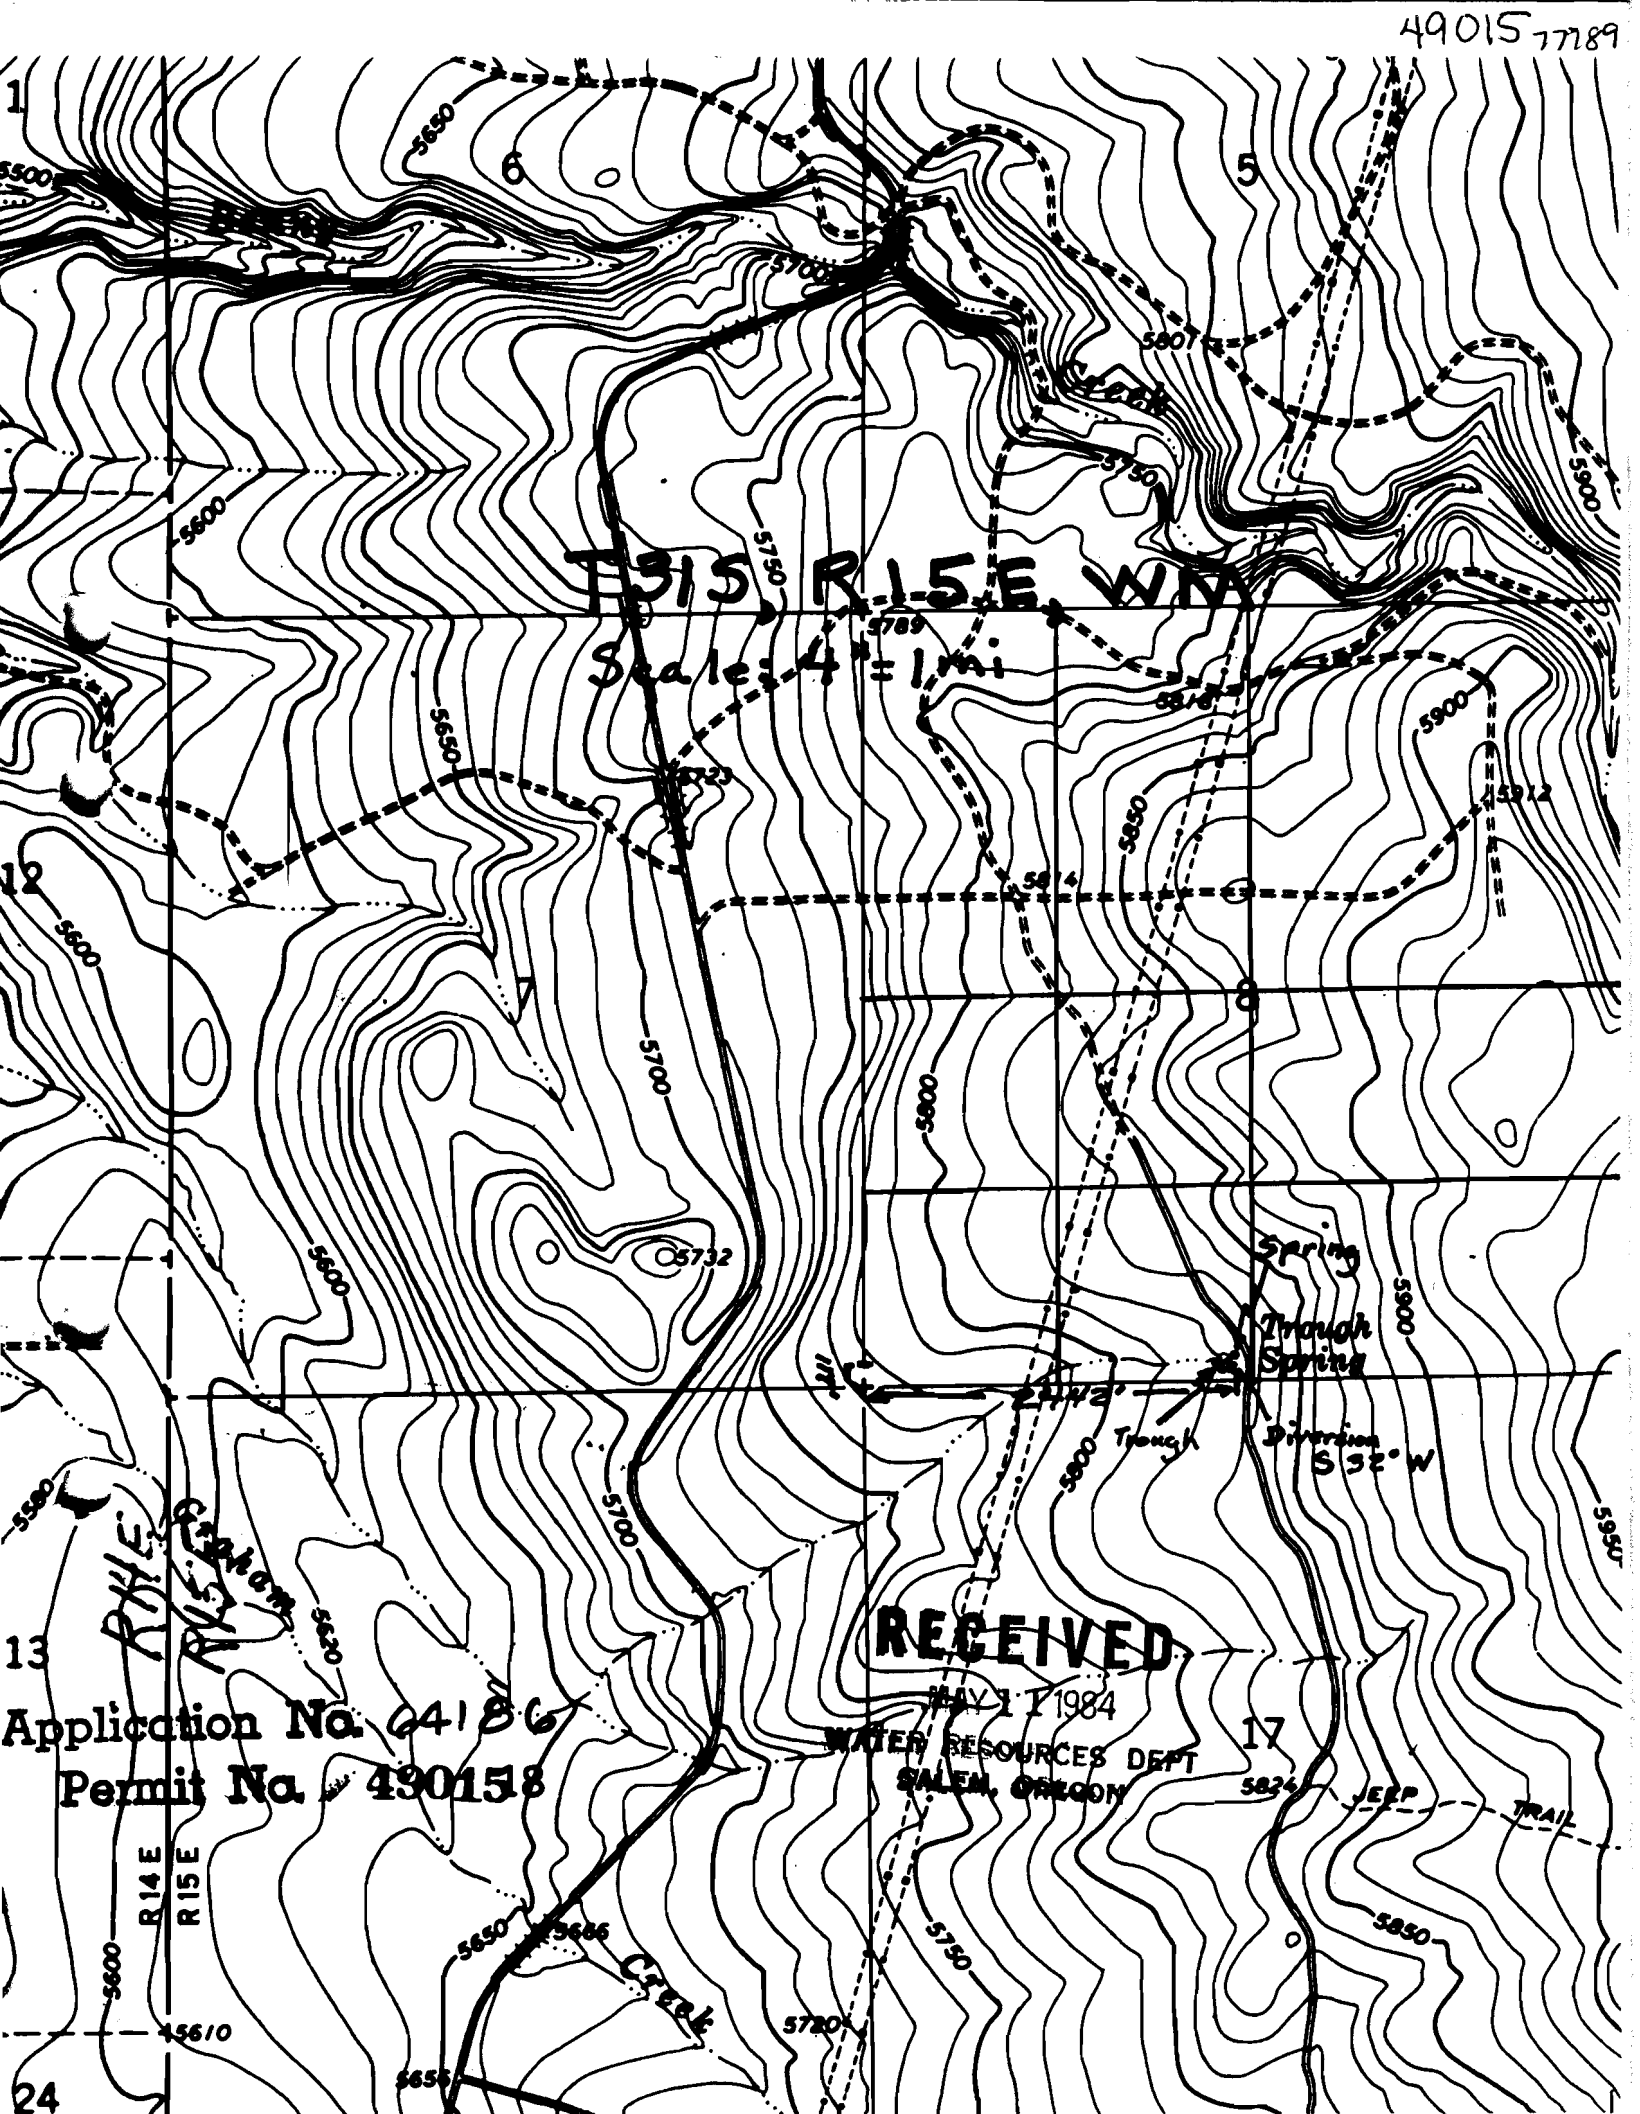

T31S, R15E, W11
Scale: 4" = 1 mi

RECEIVED
MAY 1 1984
WATER RESOURCES DEPT
SALEM, OREGON

Application No. 64186
Permit No. 490158

17
5824
JEEP TRAIL
5850

24
5600
R14E
R15E
5610
5650
5700
5750
5800
5850
5900
5912
5907
5807
5700
5650
5600
5500
