


77790

12
APP 62016
Permit 49469

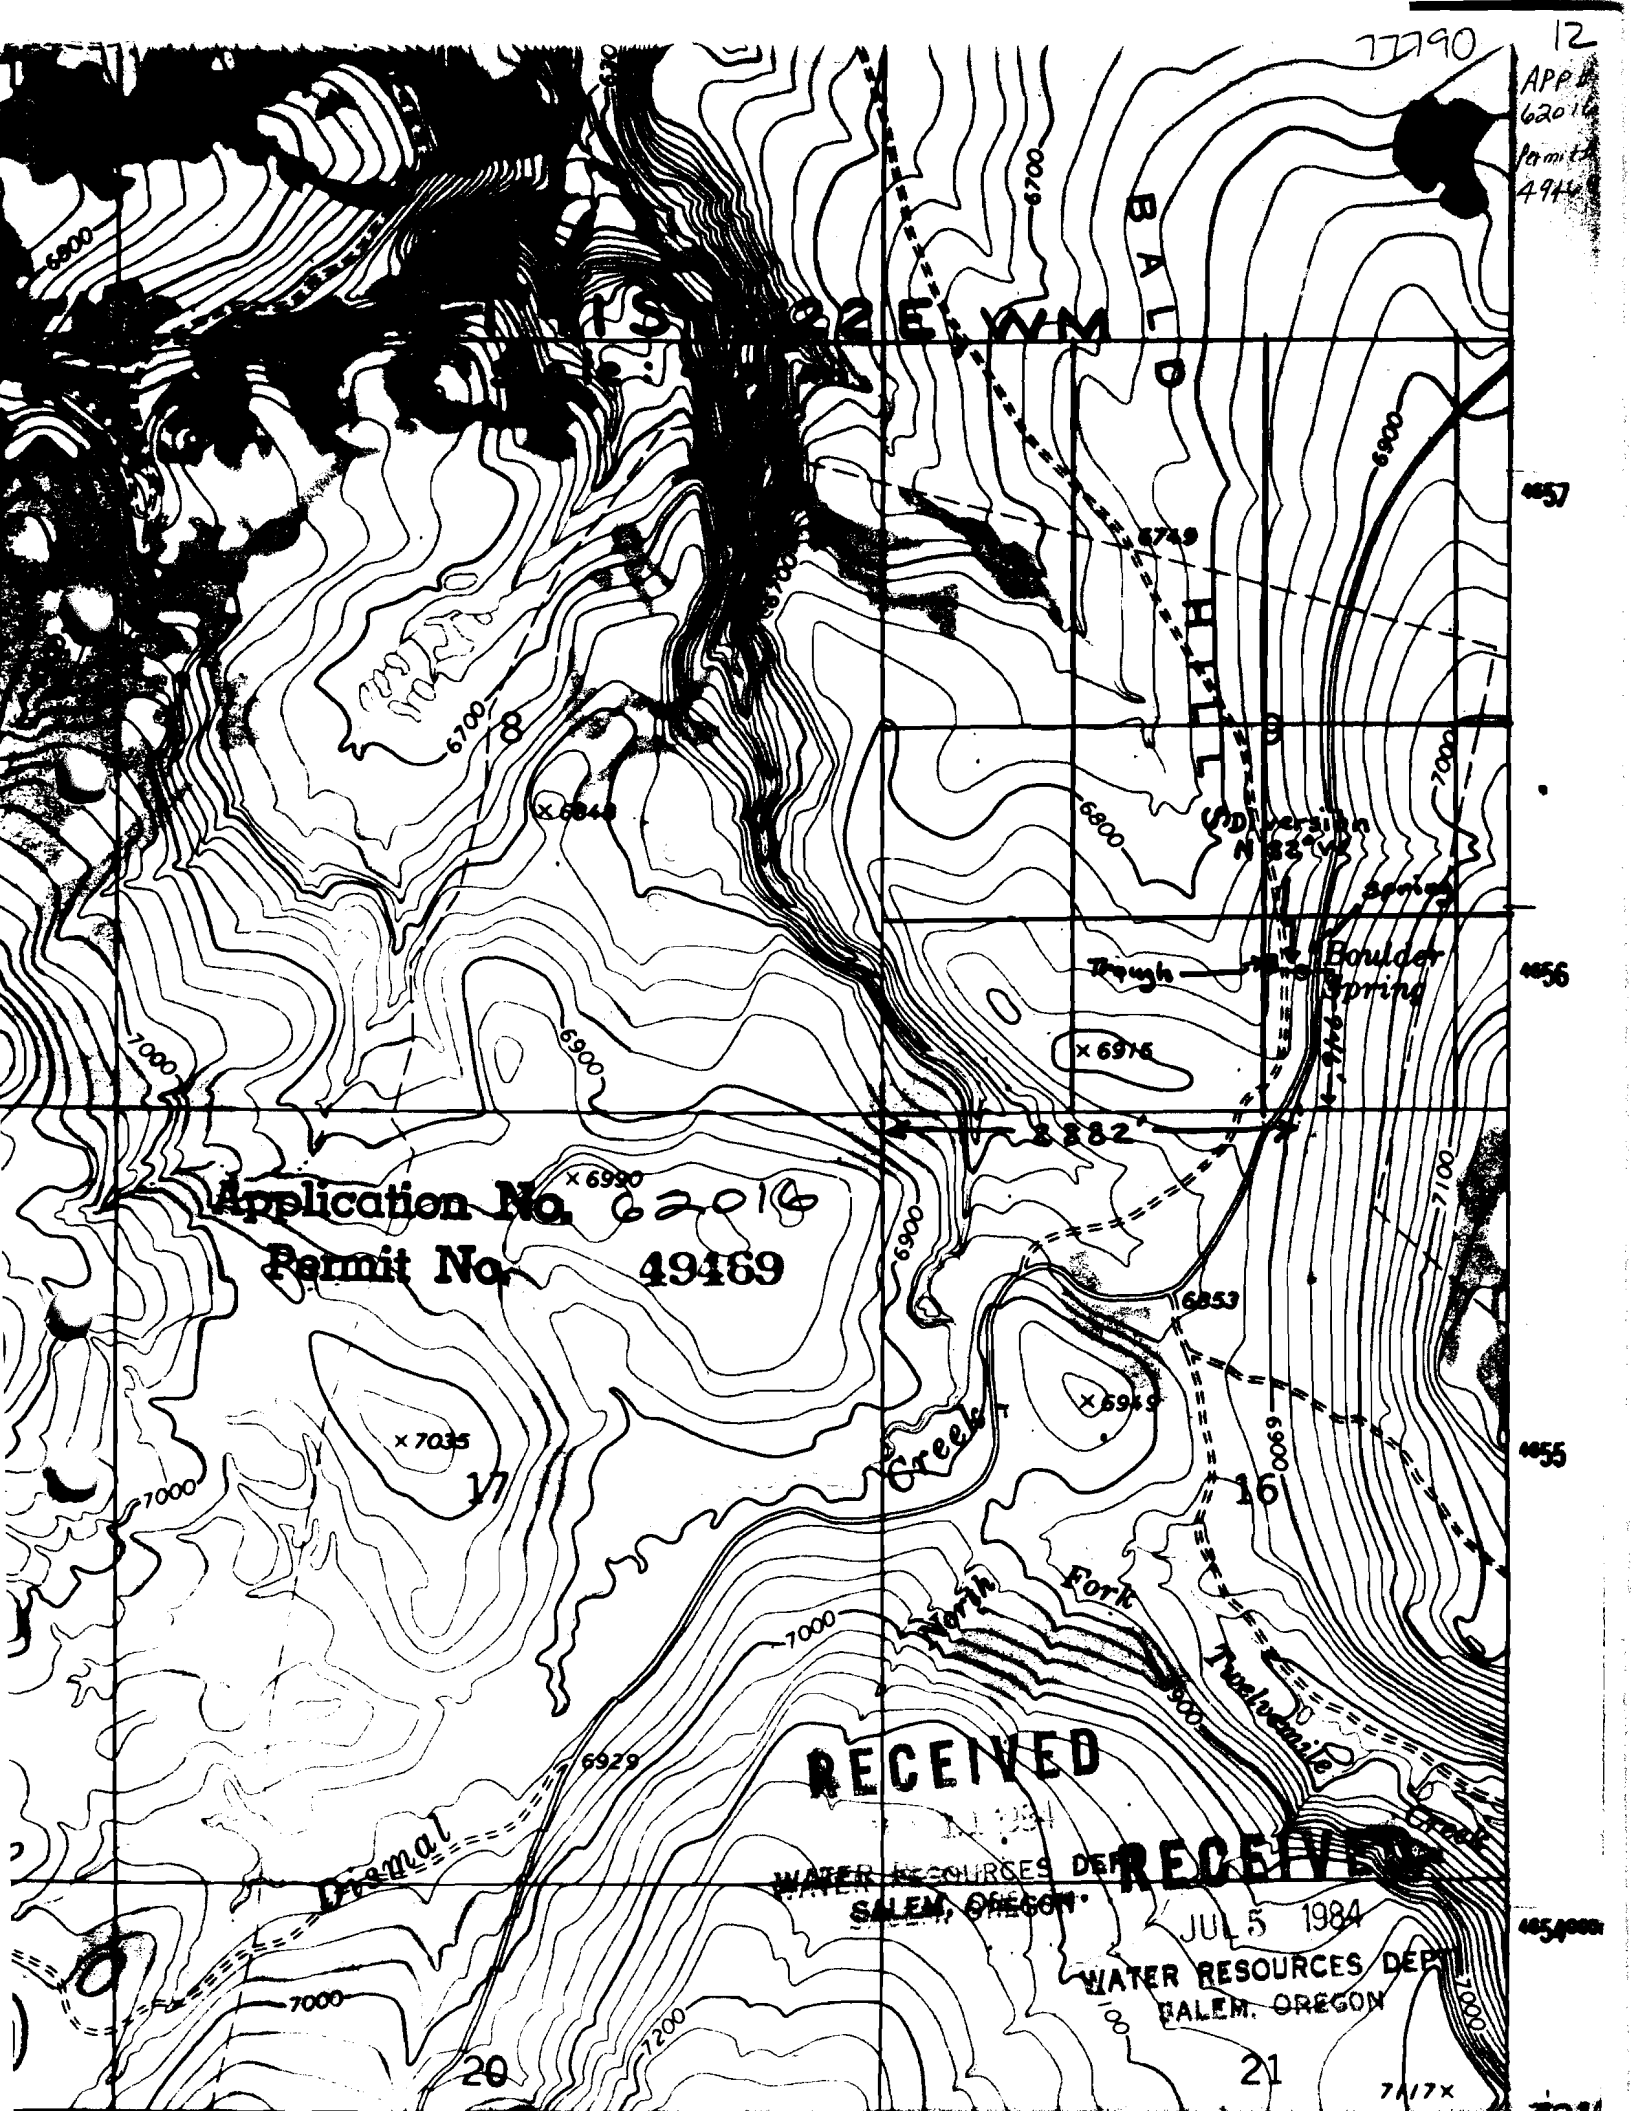

Application No. 62016
Permit No. 49469

RECEIVED

WATER RESOURCES DEPT.
SALEM, OREGON

RECEIVED

JUL 5 1984
WATER RESOURCES DEPT.
SALEM, OREGON

7417X