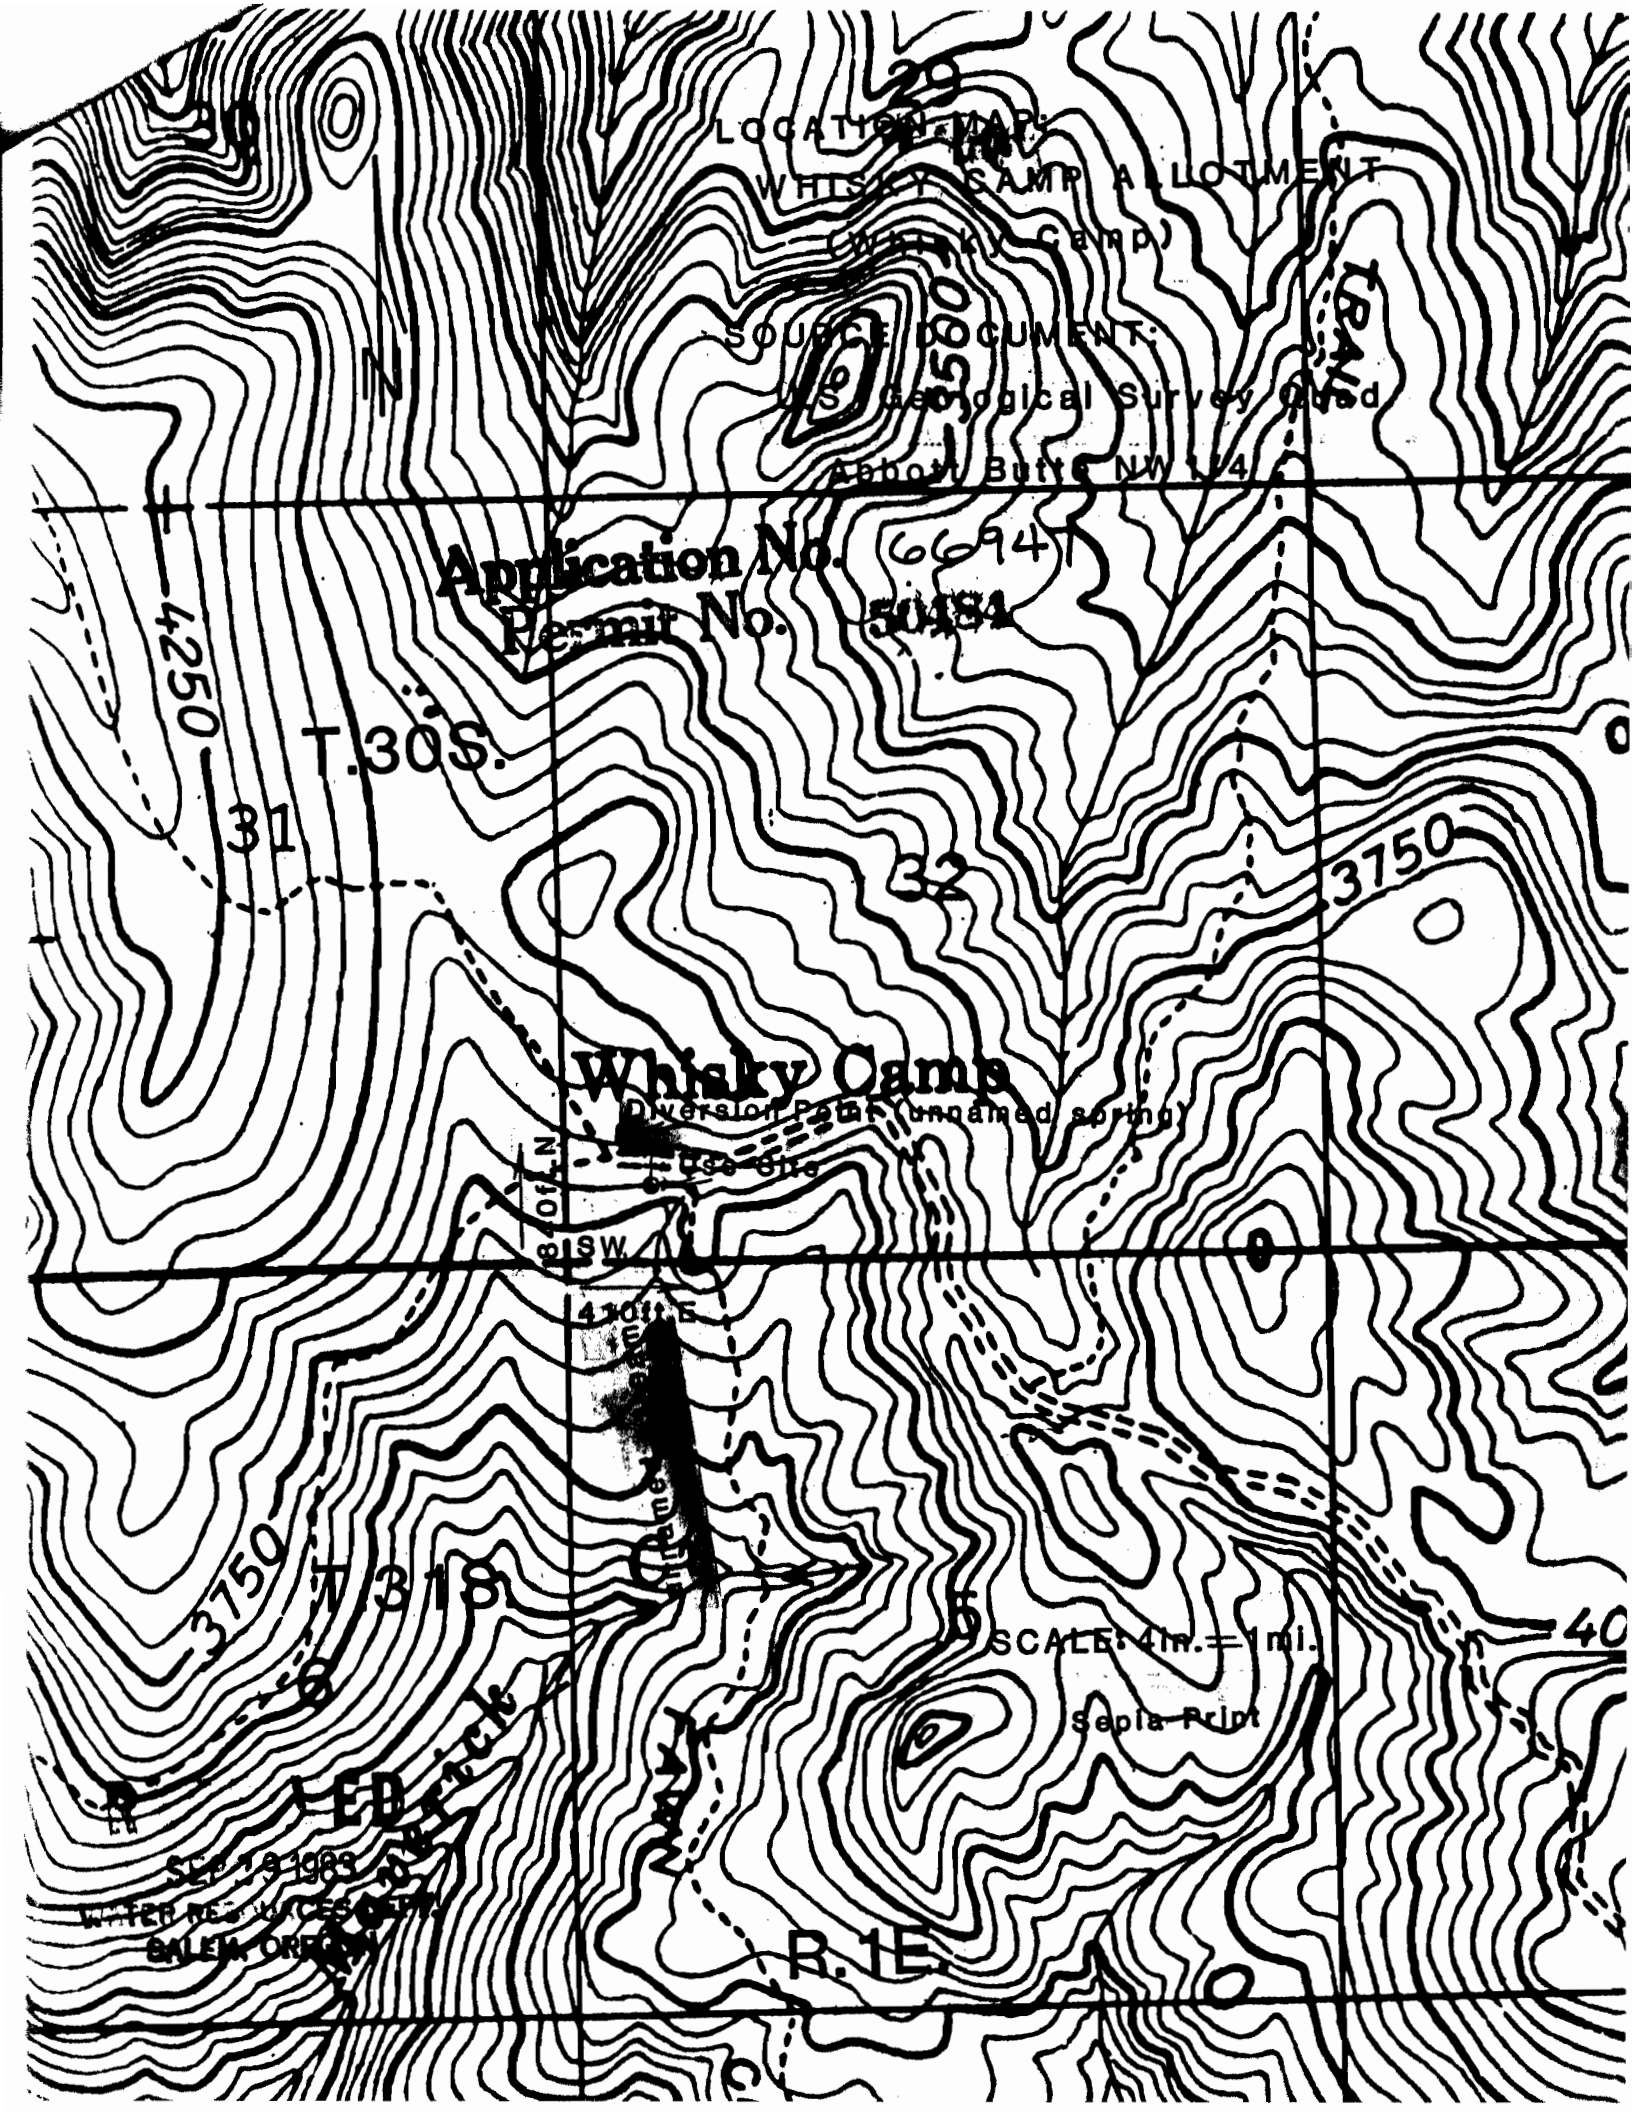
LOCATION MAP:
WHISKY CAMP ALLOTMENT
(Whisky Camp)
SOURCE DOCUMENT:
U.S. Geological Survey Quad
Abbott Butte NW 1/4
Application No. 66941
Permit No. 50484
T.30S.
R.1E.
Whisky Camp
Diversion Point (unnamed spring)
SCALE: 4in.=1mi.
Sepia Print
SEP 9 1983
WATER RESOURCES DEPT
SALEM, OREGON