


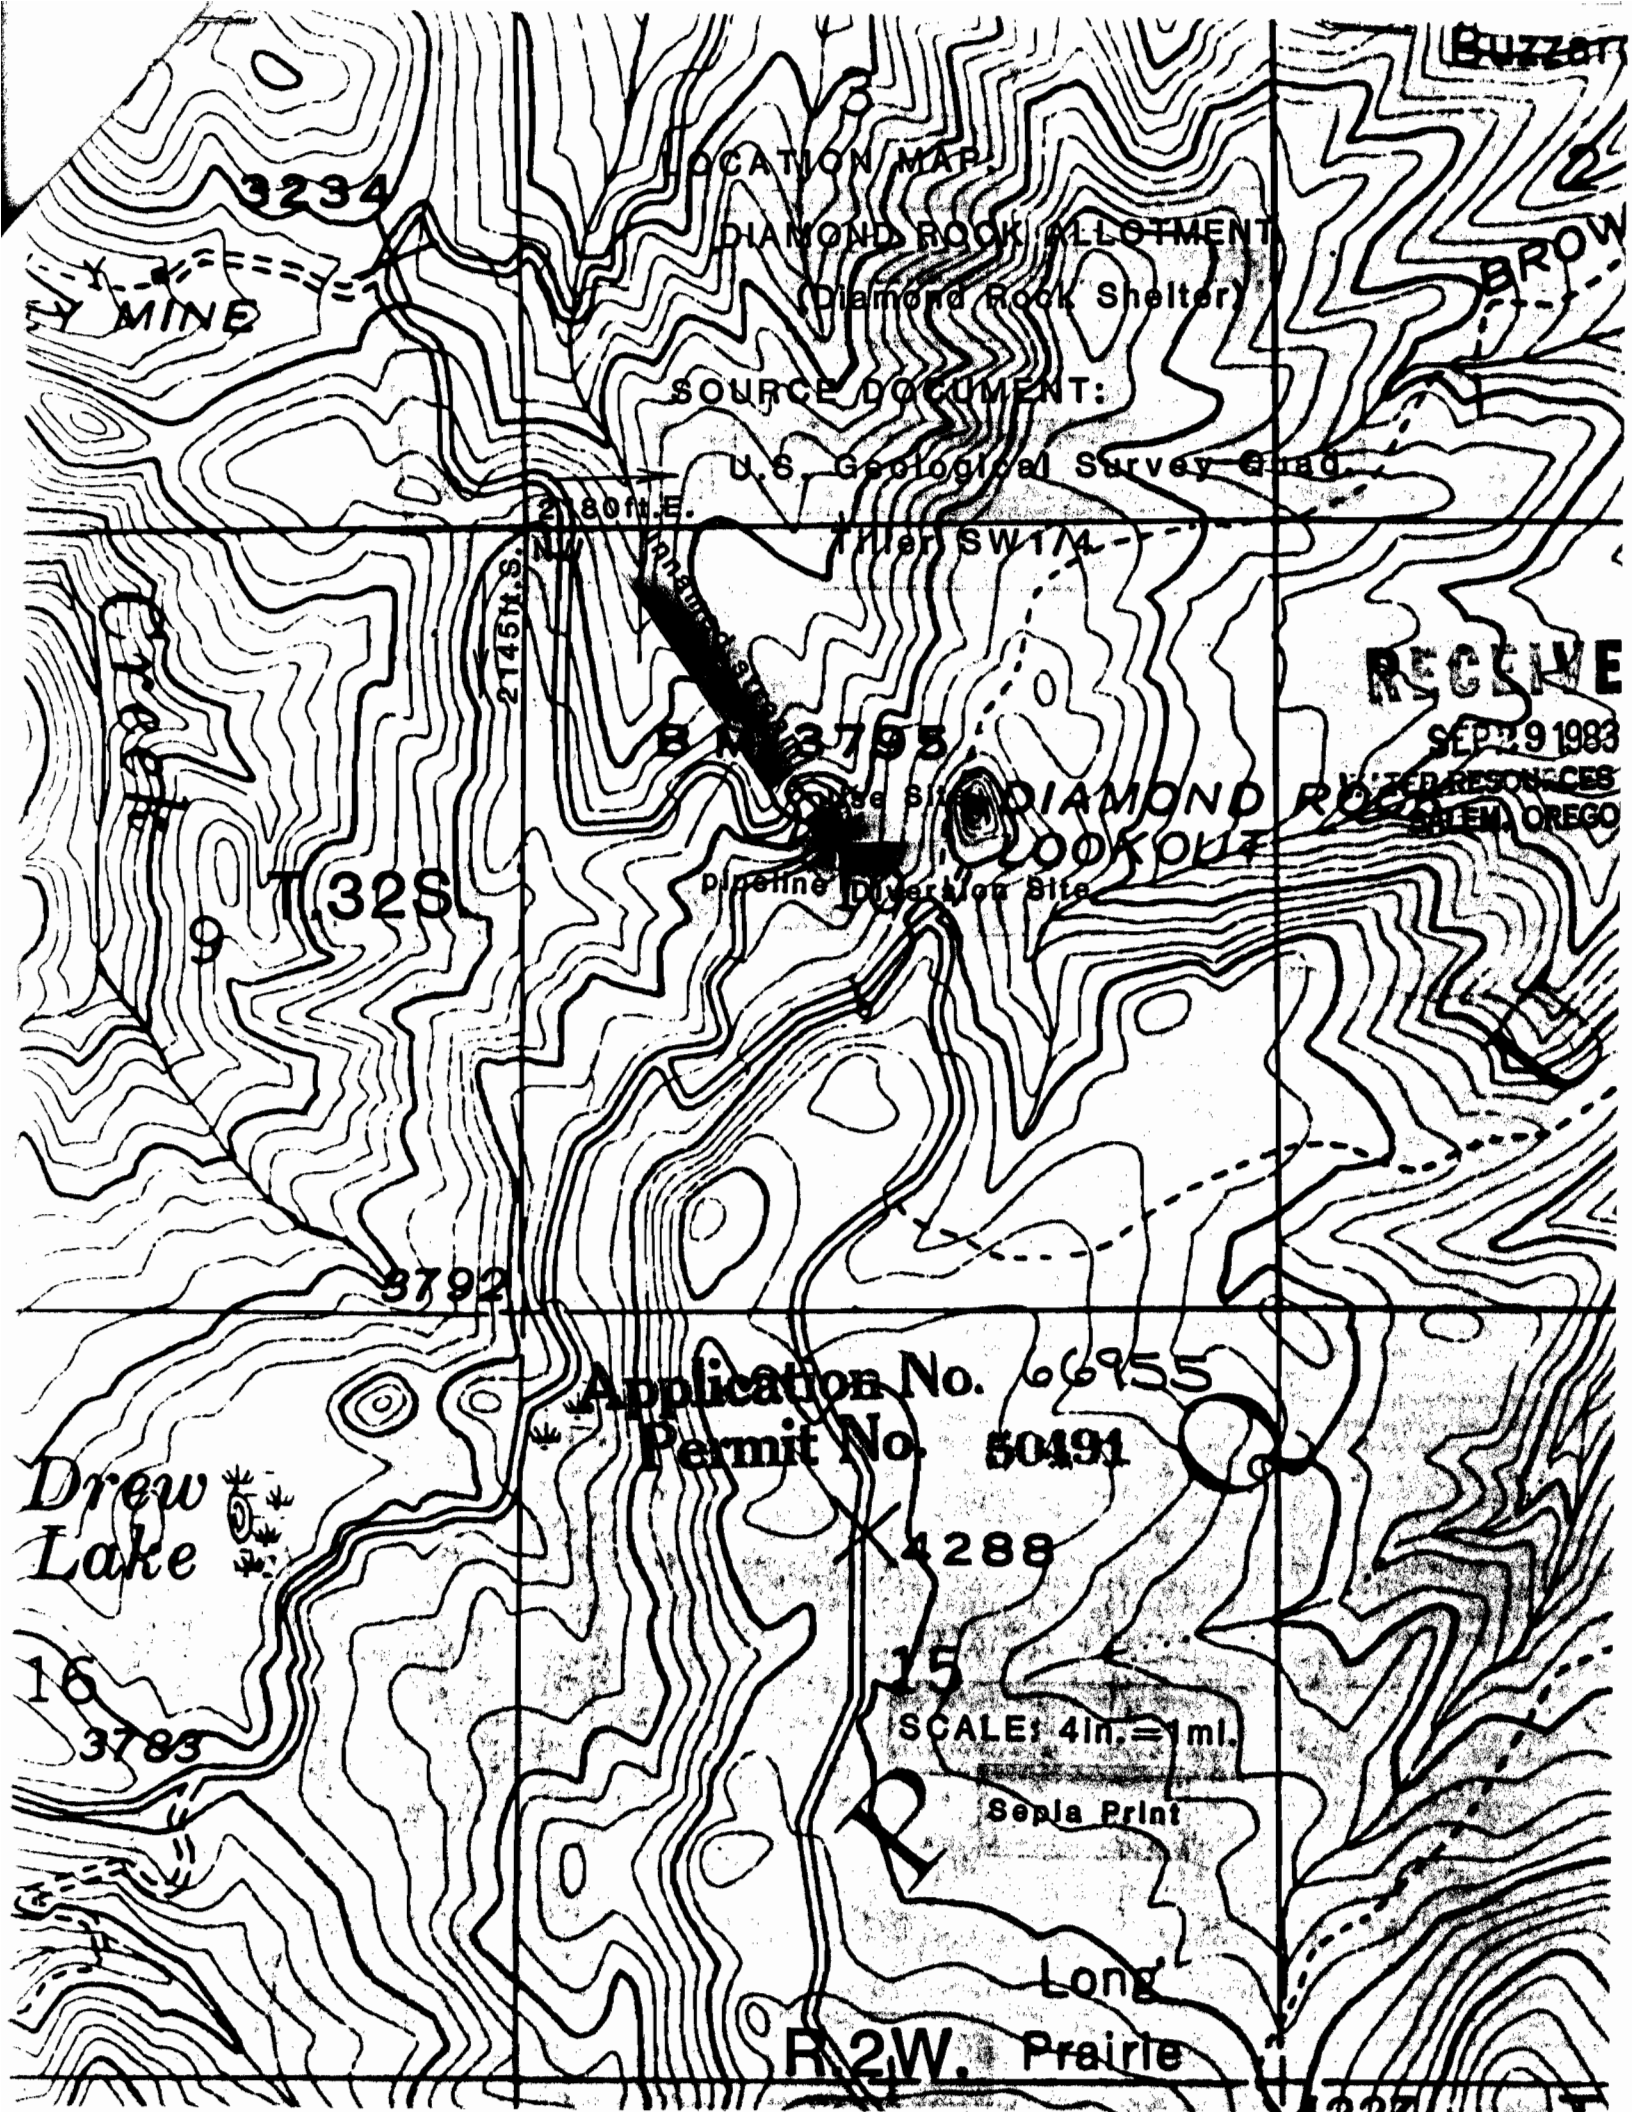

3234

LOCATION MAP

DIAMOND ROCK ALLOTMENT
(Diamond Rock Shelter)

SOURCE DOCUMENT:

U.S. Geological Survey Quad

2180M.E.

2145M.S.

B.M. 3795

DIAMOND ROCK
LOOKOUT

pipeline Diversion Site

3792

Application No. 66955

Permit No. 50491

X 4288

Drew Lake

SCALE: 4in. = 1mi.

Sepia Print

Long

R.2W. Prairie

RECEIVED

SEP 29 1983

UNITED RESOURCES
SALEM, OREGO

16

3783

15