


T. 19 S., R. 26 E., W.M.

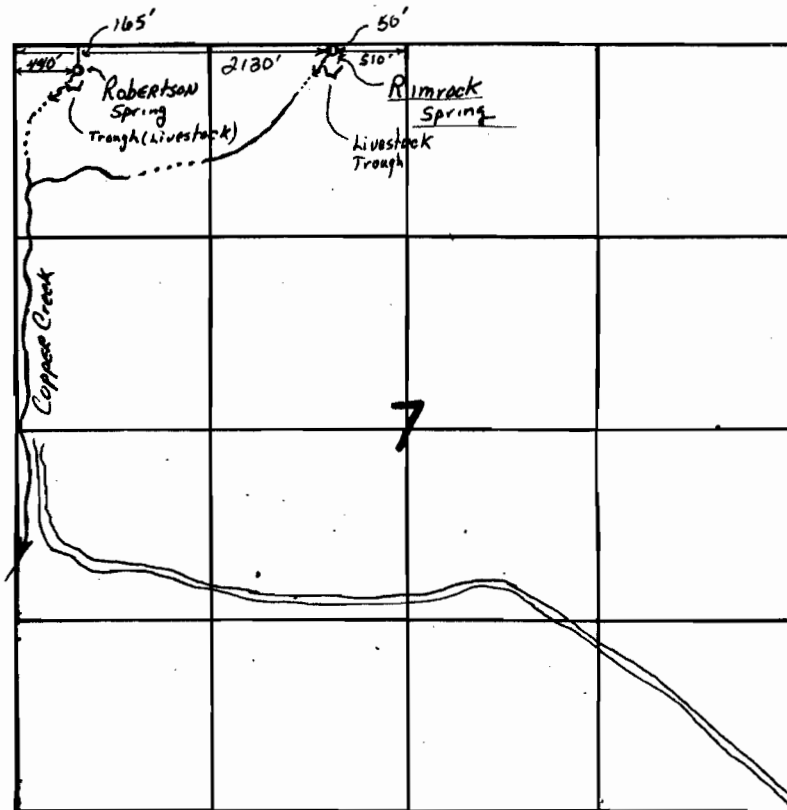

SCALE - 4" = 1 MILE

R E D

OCT 18 1983

**V. TER RESOURCES DEPT.
SALEM, OREGON**

**Application No. 7552
Permit No. 50811**