


PUBLISHED

OCT 18 1983

WATER RESOURCES DEPT.
SALEM, OREGON

T.19 S., R. 27 E., W.M.

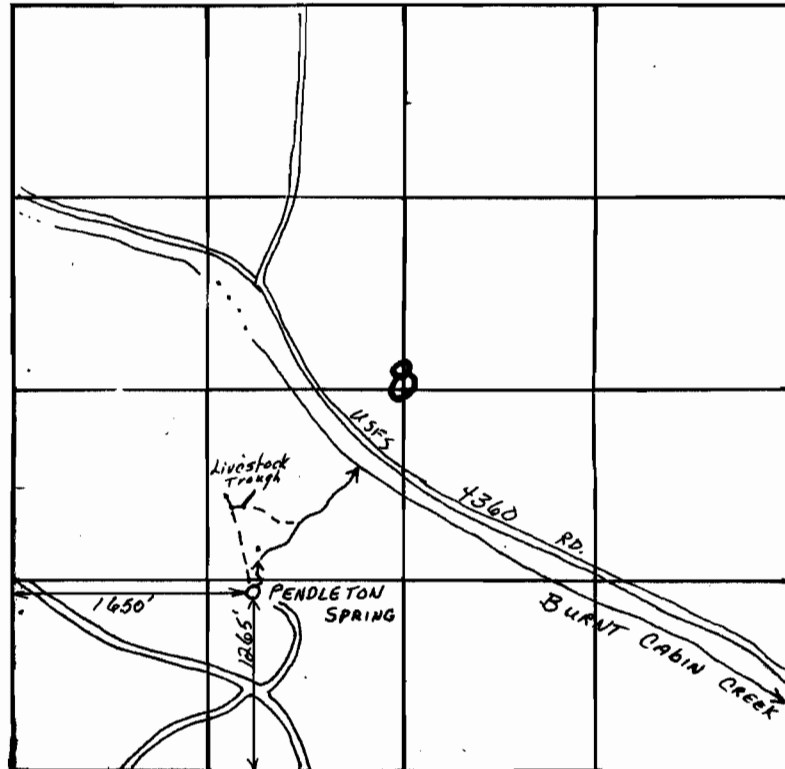

SCALE - 4" = 1 MILE

Application No. 67555
Permit No. 50813