


PERMITTED

007161983
WATER RESOURCES DEPT.
SALEM, OREGON

T.20S., R. 25E., W.M.

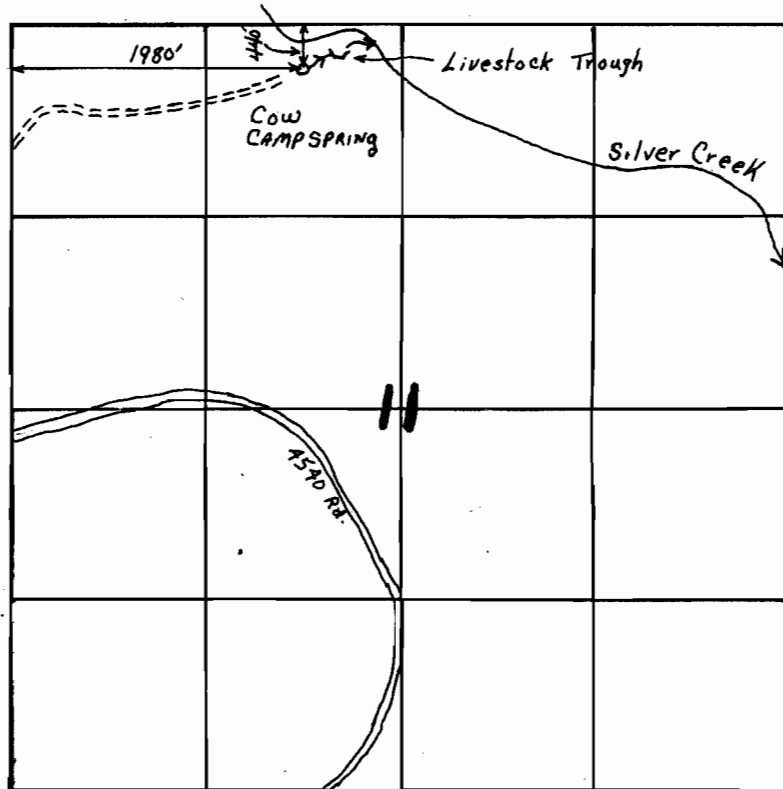

SCALE - 4" = 1 MILE

Application No. 67558
Permit No. 50816