


PRINTED

OCT 18 1983  
WATER RESOURCES DEPT.  
SALEM, OREGON

T.20S., R. 26E., W.M.

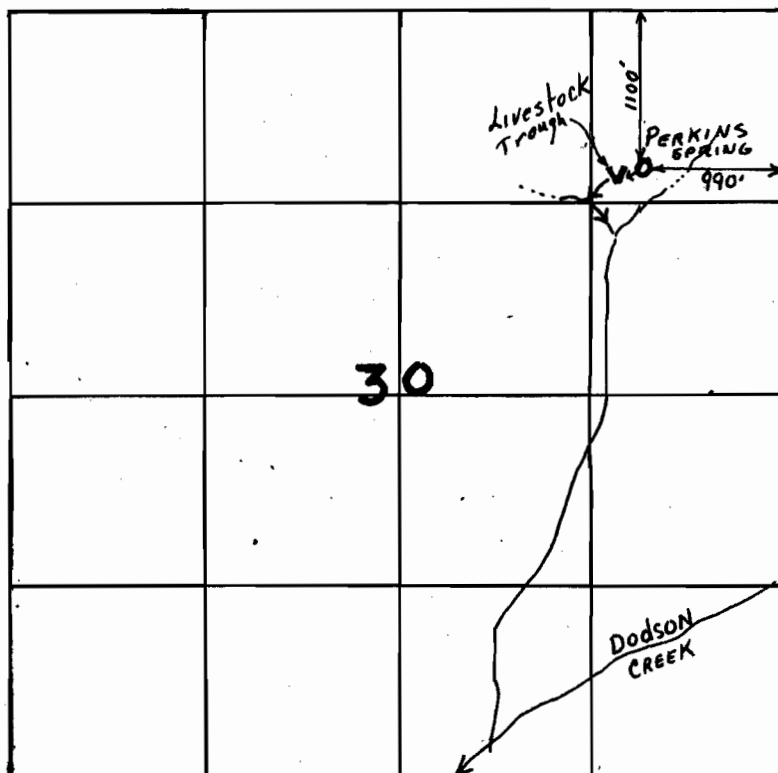

SCALE - 4" = 1 MILE

Application No. 67559  
Permit No. 50817