


P E D

007181983

WATER RESOURCES DEPT.
SALEM, OREGON

T.18 S., R. 27 E., W.M.

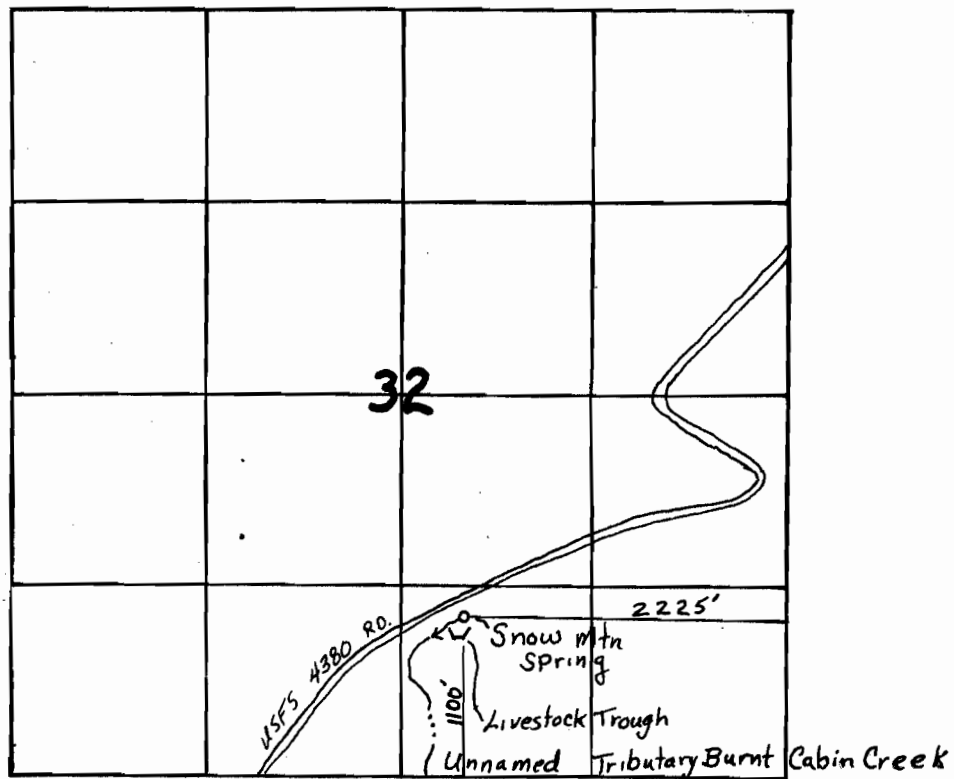

SCALE - 4" = 1 MILE

Application No. 67560

Permit No. 50818