


ED

OCT 13 1983

WATER RESOURCES DEPT.
SALEM, OREGON

T.21 S., R. 28 E., W.M.

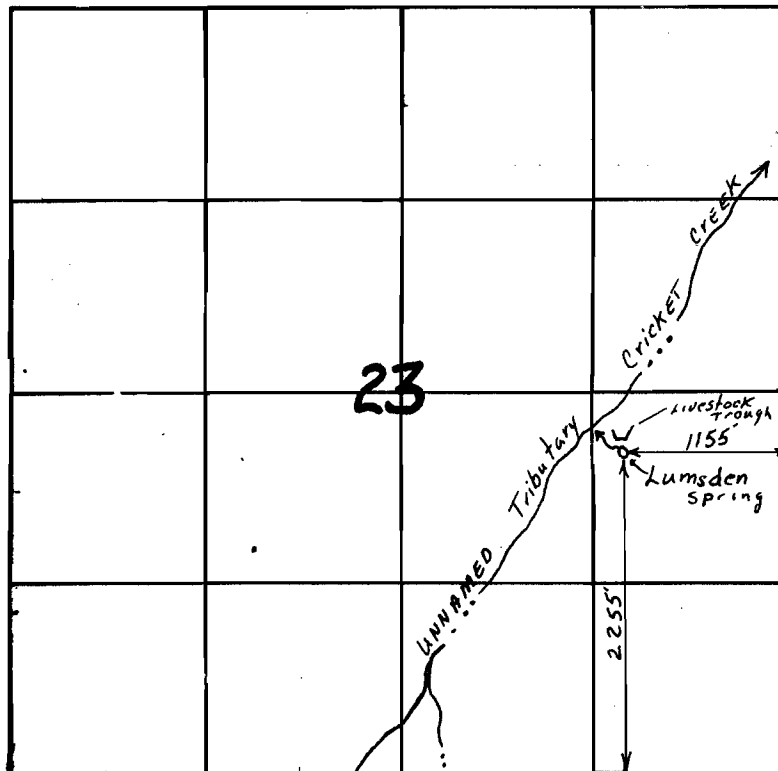

SCALE - 4" = 1 MILE

Application No. 67562
Permit No. 50820