


P E D

OCT 13 1983
WATER RESOURCES DEPT.
SALEM, OREGON

T.19 S., R. 27 E., W.M.

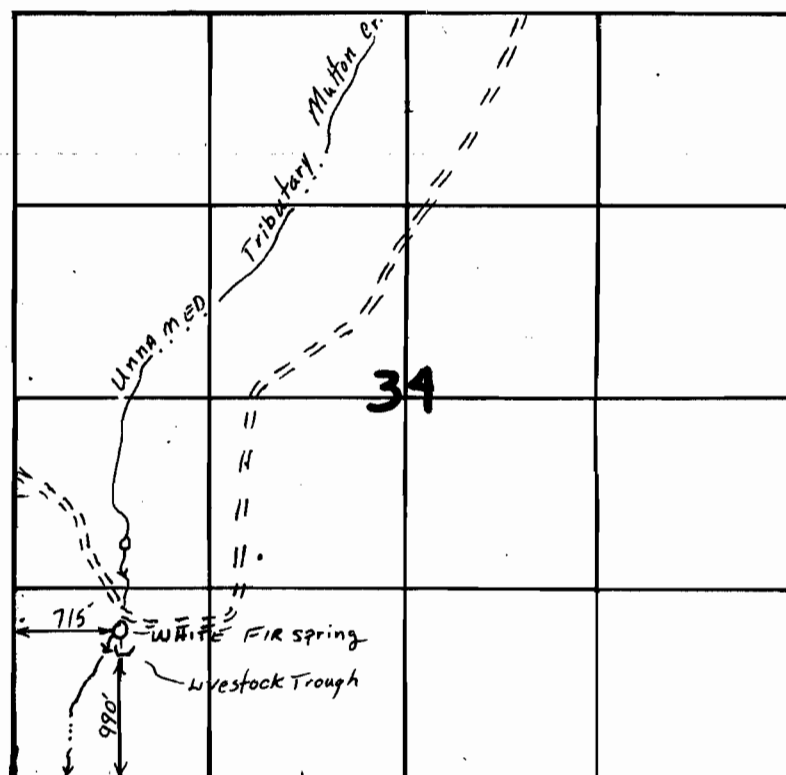

SCALE - 4" = 1 MILE

Application No. 67564
Permit No. 50822