


RECEIVED

00713 1983
WATER RESOURCES DEPT.
SALEM, OREGON

T.20S., R. 27E., W.M.

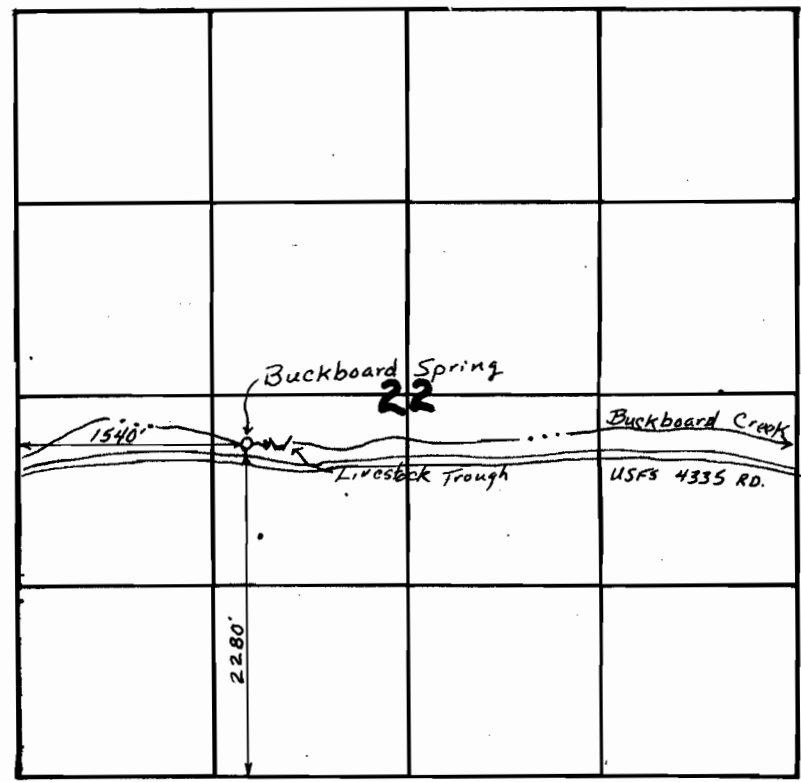

SCALE - 4" = 1 MILE

Application No. 67566
Permit No. 50824