


ED
OCT 18 1983
WATER RESOURCES DEPT.
SALEM, OREGON

T. 19 S., R. 26 E., W.M.

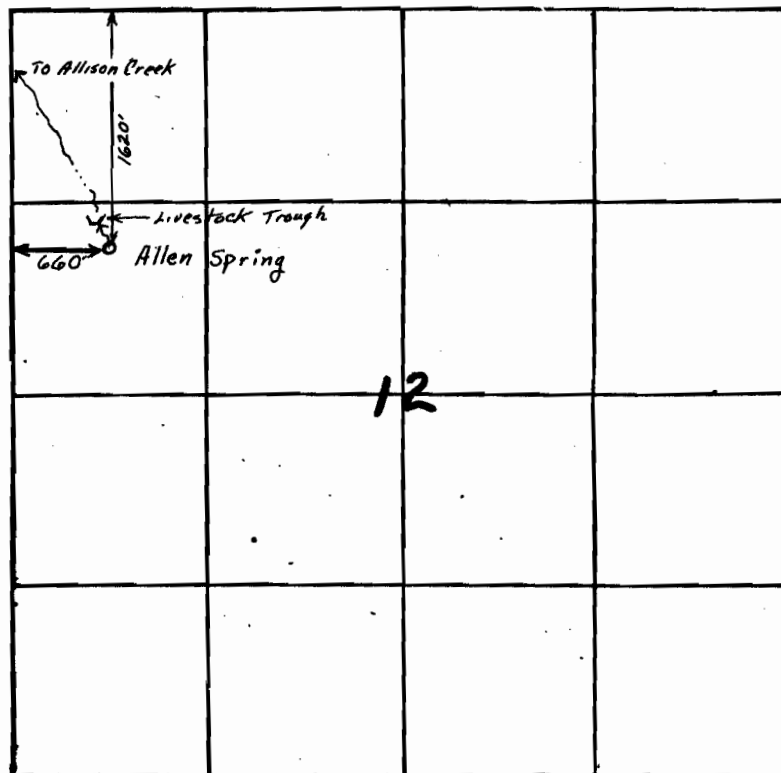

SCALE - 4" = 1 MILE

Application No. 67567
Permit No. 50825