


RECEIVED

OCT 18 1983

**WATER RESOURCES DEPT.
SALEM, OREGON**

T.19 S., R. 25 E., W.M.

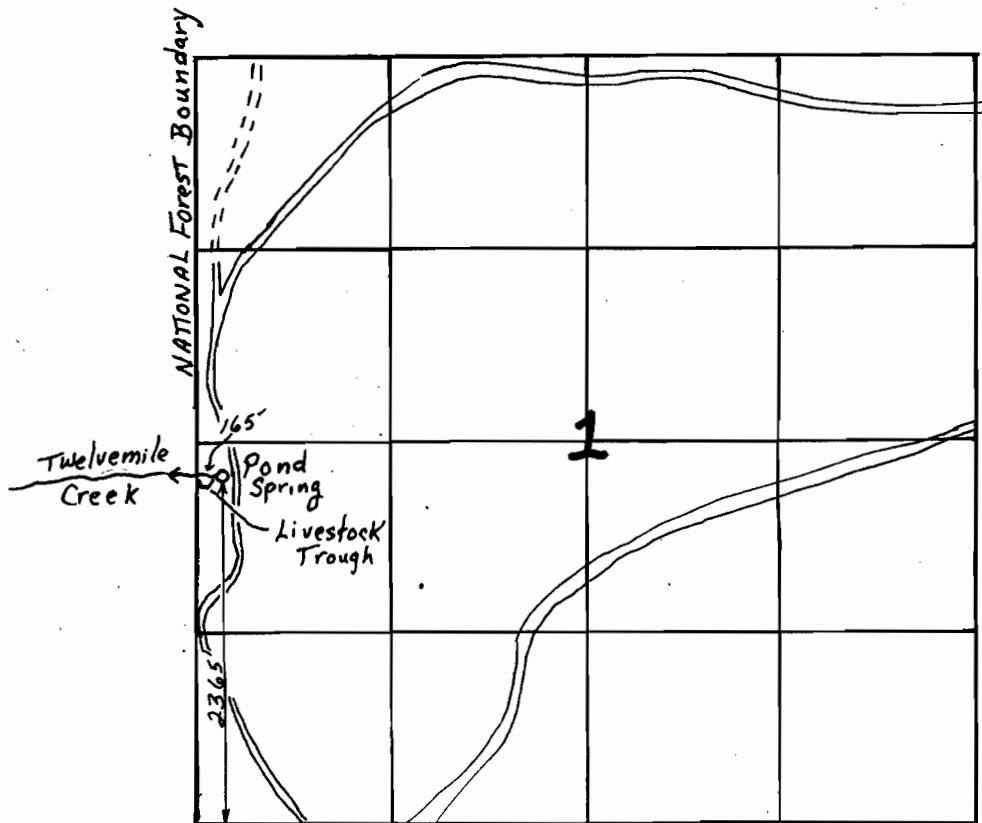

Application No. 67554
Permit No. 51254