


T.15S. R.21E. Sec. 8


T.15S. R.21E. Sec. 9

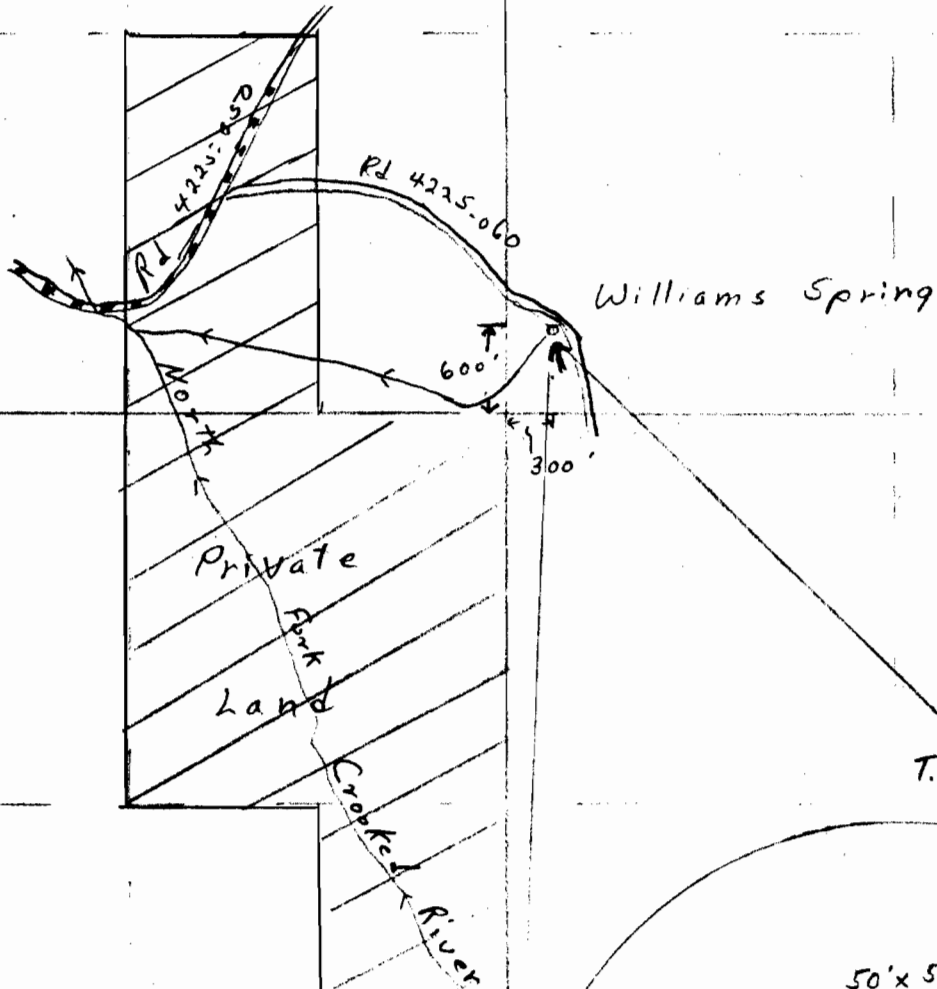

T.15S. R.21E. Sec. 16

T.15S. R.21E. Sec. 17

**RECEIVED**  
SEP 19 1983  
WATER RESOURCES DEPT.  
SALEM, OREGON

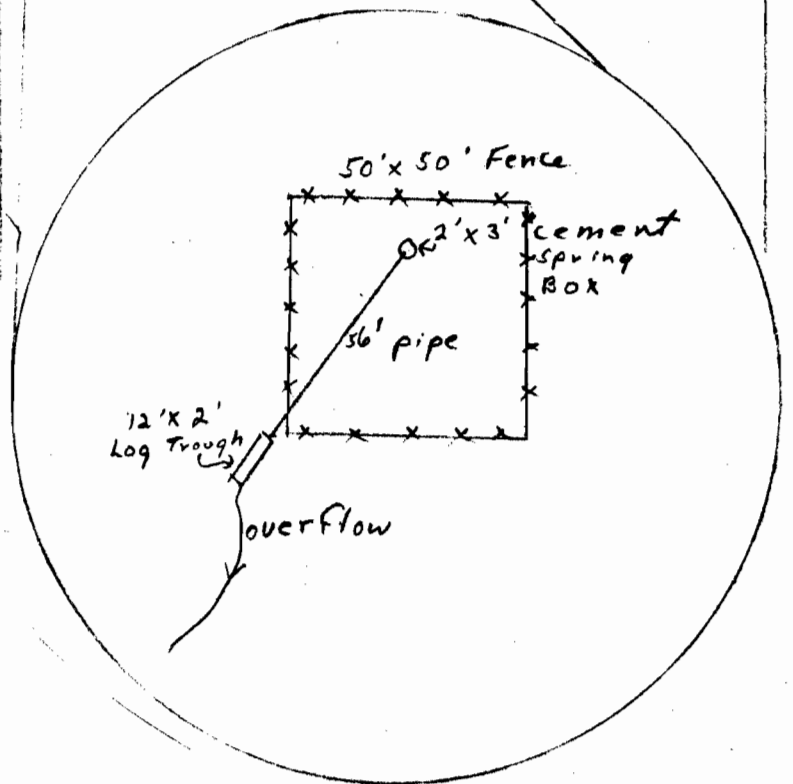

SCALE: 4 Inches = 1 Mile

**Application No. 66417**  
**Permit No. 51291**

