


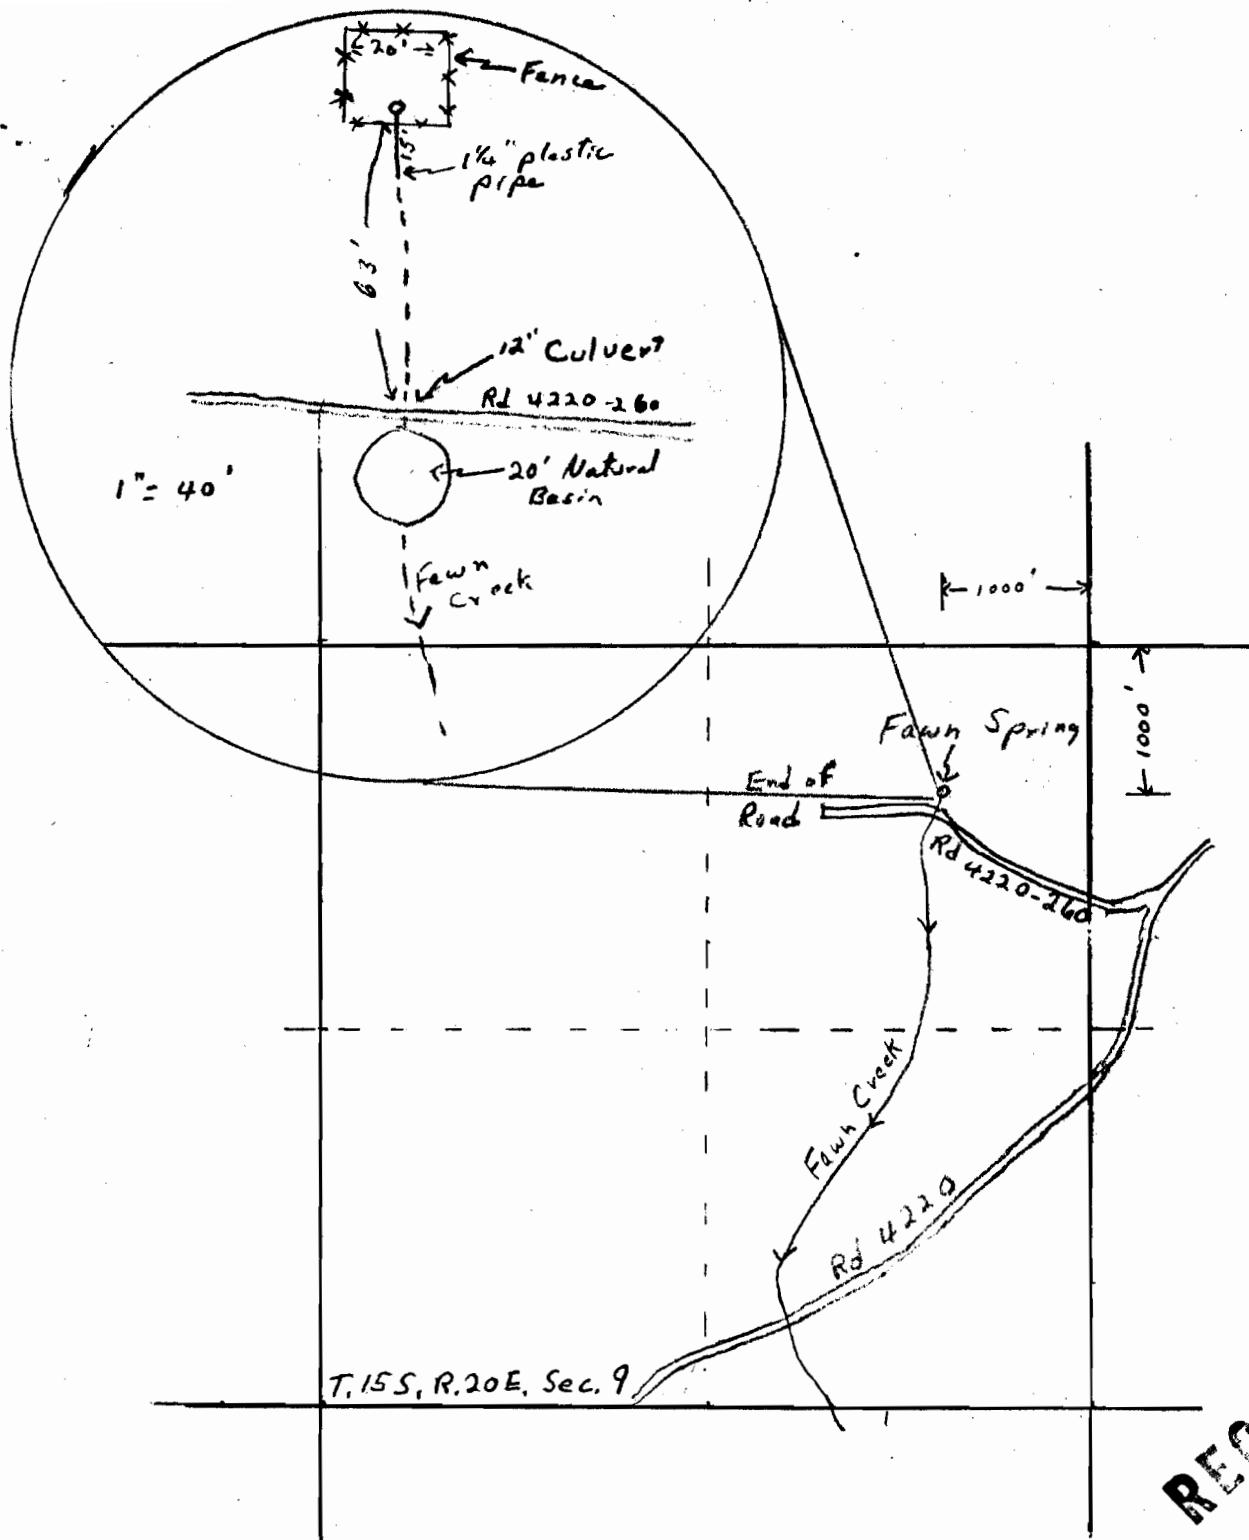

SCALE: 4 Inches = 1 Mile

NORTH



Application No. 66418
Permit No. 51292

RECEIVED
SEP 19 1983
WATER RESOURCES DEPT.
SALEM, OREGON